

15-007-00149-00-01

STATE OF KANSAS
STATE CORPORATION COMMISSION


Give All Information Completely
Make Required Affidavit
Mail or Deliver Report to:
Conservation Division
State Corporation Commission
211 No. Broadway
Wichita, Kansas

WELL PLUGGING RECORD

Barber County. Sec. 3 Twp. 35 Rge. 15 (W)

Location as "NE/CNW/SW" or footage from lines NW 1/4 - NW 1/4 - NW 1/4
Lease Owner Champlin Oil & Refining Co.
Lease Name Davis Ranch "A" Well No. 1
Office Address Box #293, Ellinwood, Kansas.
Character of Well (completed as Oil, Gas or Dry Hole) Gas Well
Date well completed February 28, 19 55
Application for plugging filed February 26, 19 62
Application for plugging approved March 2, 19 62
Plugging commenced April 2, 19 62
Plugging completed April 7, 19 62
Reason for abandonment of well or producing formation Would not produce commercial quantities.
If a producing well is abandoned, date of last production Never sold gas. 19
Was permission obtained from the Conservation Division or its agents before plugging was commenced? Yes

NORTH

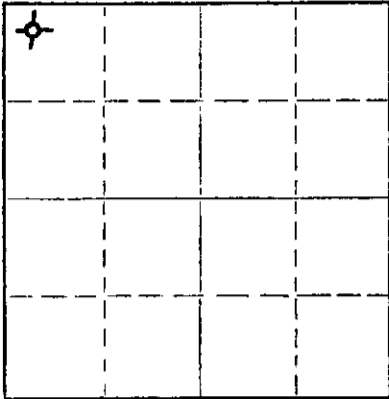

Locate well correctly on above Section Plat

Name of Conservation Agent who supervised plugging of this well Fred Hample, Pretty Prairie, Kansas.
Producing formation _____ Depth to top _____ Bottom _____ Total Depth of Well 5738' Feet
Show depth and thickness of all water, oil and gas formations. 4877' PBTD

OIL, GAS OR WATER RECORDS

CASING RECORD

FORMATION	CONTENT	FROM	TO	SIZE	PUT IN	PULLED OUT
				10 3/4"	962'	None
				7"OD	5700'	4025'

Describe in detail the manner in which the well was plugged, indicating where the mud fluid was placed and the method or methods used in introducing it into the hole. If cement or other plugs were used, state the character of same and depth placed, from _____ feet to _____ feet for each plug set.

Dumped 10 sacks of cement on top of plug, filled hole with mud to 400' set rock bridge and dumped 25 sacks of cement and filled hole with mud to 25' and filled hole with 15 sacks of cement filling hole to bottom of celler. Filled cellar with dirt.

RECEIVED
STATE CORPORATION COMMISSION
APR 13 1962
4-18-62
CONSERVATION DIVISION
Wichita, Kansas

(If additional description is necessary, use BACK of this sheet)

Name of Plugging Contractor Pipe Pullers, Inc.
Address Box 486, Ellinwood, Kansas.

STATE OF Kansas COUNTY OF Barton, ss.
J. W. Meyers (employee of owner) or (owner) of the above-described well, being first duly sworn on oath, says: That I have knowledge of the facts, statements, and matters herein contained and the log of the above-described well as filed and that the same are true and correct. So help me God.

(Signature) J. W. Meyers
Box 293, Ellinwood, Kansas, Dist. Supt.
(Address)

SUBSCRIBED AND SWORN TO before me this 16th day of April, 19 62

My commission expires 5/22/62

Notary Public.



Champlin Oil & Refining Co.
 Davis Ranch A #1
 NW-NW-NW 3-35S-15W
 Barber County, Kansas

0 - 30'	Surface Sand & Shale
30' - 1585'	Shale & Shells
1585' - 2260'	Lime & Shale
2260' - 2360'	Sandy Lime & Shale
2360' - 2560'	Shale & Lime
2560' - 2715'	Lime & Shale
2715' - 3110'	Shale & Lime
3110' - 3875'	Lime & Shale
3875' - 4000'	Shale & Lime
4000' - 4105'	Sandy Lime & Shale
4105' - 4345'	Shale & Lime
4345' - 4540'	Lime
4540' - 4605'	Lime & Shale
4605' - 4715'	Lime
4715' - 4755'	Lime & Shale
4755' - 4805'	Lime
4805' - 5108'	Lime & Shale
5108' - 5167'	Shale & Lime
5167' - 5289'	Lime
5289' - 5320'	Shale
5320' - 5520'	Lime & Chalky Lime
5520' - 5532'	Shale
5532' - 5577'	Sand
5577' - 5636'	Sandy Shale
5636' - 5652'	Sand
5652' - 5664'	Sandy Shale
5664' - 5738'	Dolomite
5738' - Total Depth	

RECEIVED
 STATE CORPORATION COMMISSION

FEB 27 1962
 2-27-62
 CONSERVATION DIVISION
 Wichita, Kansas