

STATE CORPORATION COMMISSION OF KANSAS
OIL & GAS CONSERVATION DIVISION
WELL COMPLETION OR RECOMPLETION FORM
ACO-1 WELL HISTORY
DESCRIPTION OF WELL AND LEASE

Operator: License # 5151
Name Gear Petroleum Company, Inc.
Address 1075 Kansas State Bank Building
City/State/Zip Wichita, Kansas 67202

Purchaser N/A

Operator Contact Person Jim Thatcher
Phone 316-265-3351

Contractor: License # 5302
Name Red Tiger Drilling Company

Wellsite Geologist Jim Reeves
Phone (913) 475-3325

Designate Type of Completion

X New Well Re-Entry Workover
Oil SWD Temp Abd
Gas Inj Delayed Comp.
X Dry Other (Core, Water Supply etc.)

If OWN: old well info as follows:
Operator
Well Name
Comp. Date Old Total Depth

WELL HISTORY

Drilling Method:
X Mud Rotary Air Rotary Cable
5/27/88 6/6/88 6/7/88
Spud Date Date Reached TD Completion Date
4,924'
Total Depth PBTD
Amount of Surface Pipe Set and Cemented at 416 feet
Multiple Stage Cementing Collar Used? Yes No
If yes, show depth set feet
If alternate 2 completion, cement circulated from feet depth to w/ SX cmt
Cement Company Name
Invoice # AIT II D&D

API NO. 15-171-20-371-00-00

County Scott
C NE/4 NE/4 35 20S 34W East
Sec. Twp. Rge. East West

4620 Ft North from Southeast Corner of Section
660 Ft West from Southeast Corner of Section
(Note: Locate well in section plat below)


Lease Name Crist Well # 1-35

Field Name

Producing Formation N/A

Elevation: Ground 2976' NB 2981'

Section Plat

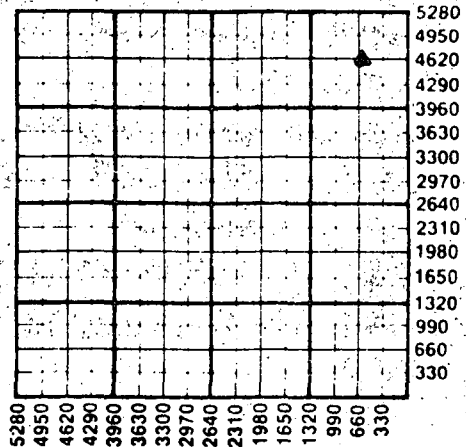

WATER SUPPLY INFORMATION

Disposition of Produced Water: Disposal
Docket # Repressuring

Questions on this portion of the ACO-1 call:

Water Resources Board (913) 296-3717

Source of Water:
Division of Water Resources Permit # T88-272

X Groundwater 4640 Ft North from Southeast Corner
750 Ft West from Southeast Corner of Section
35 Twp 20S Rge 34W East X West

Surface Water Ft North from Southeast Corner
(Stream, pond, etc) Ft West from Southeast Corner
Sec Twp Rge East West

Wichita, Kansas (purchased from city, R.W.D. #)

INSTRUCTIONS: This form shall be completed in triplicate and filled with the Kansas Corporation Commission, 200 Colorado Derby Building, Wichita, Kansas 67202, within 120 days of the spud date of any well. Rule 82-3-130, 82-3-107 and 82-3-106 apply. Information on side two of this form will be held confidential for a period of 12 months if requested in writing and submitted with the form. See rule 82-3-107 for confidentiality in excess of 12 months. One copy of all wireline logs and drillers time log shall be attached with this form. Submit CP-4 form with all plugged wells. Submit CP-111 form with all temporarily abandoned wells.

All requirements of the statutes, rules and regulations promulgated to regulate the oil and gas industry have been fully complied with and the statements herein are complete and correct to the best of my knowledge.

Signature Jim Thatcher
Title Dr. lg. & Production Manager Date 6/10/88

Subscribed and sworn to before me this 10th day of June 1988
Notary Public Pauletta K. Engels
Date Commission Expires 8/1/89

K.C.C. OFFICE USE ONLY
Letter of Confidentiality Attached
Wireline Log Received
Drillers Time Log Received
Distribution
KCC SMD/Rep NGPA
KGS Plug Other
(Specify)
6-16-88

SEC 25 IMP 20 Rge 34W

