


STATE OF KANSAS  
STATE CORPORATION COMMISSION  
CONSERVATION DIVISION  
P. O. BOX 17027  
WICHITA, KANSAS 67217

FORM CP-4

WELL PLUGGING RECORD

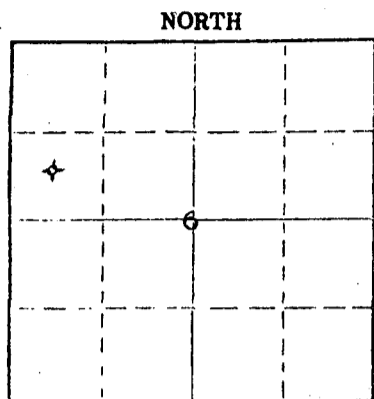

Locate well correctly on above Section Plat

Comanche County. Sec. 6 Twp. 31S Rgc. 18W (X) (W)  
Location as "NE/CNW&SW" or footage from lines 20' N of C: SW NW  
Lease Owner D. R. Lauck Oil Company, Inc.  
Lease Name Timmons "A" Well No. 1  
Office Address 221 S. Broadway, Wichita, Kansas 67202  
Character of Well (completed as Oil, Gas or Dry Hole) Dry Hole  
Date well completed April 7, 1978  
Application for plugging filed April 7, 1978  
Application for plugging approved April 7, 1978  
Plugging commenced April 7, 1978  
Plugging completed April 7, 1978  
Reason for abandonment of well or producing formation Dry Hole

If a producing well is abandoned, date of last production 19\_\_\_\_  
Was permission obtained from the Conservation Division or its agents before plugging was commenced? Yes

Name of Conservation Agent who supervised plugging of this well William T. Owen  
Producing formation \_\_\_\_\_ Depth to top \_\_\_\_\_ Bottom \_\_\_\_\_ Total Depth of Well 5155 Feet  
Show depth and thickness of all water, oil and gas formations.

OIL, GAS OR WATER RECORDS				CASING RECORD		
FORMATION	CONTENT	FROM	TO	SIZE	PUT IN	PULLED OUT
		0	245'	12-3/4"	245'	None
		0	649'	8-5/8"	649'	None

Describe in detail the manner in which the well was plugged, indicating where the mud fluid was placed and the method or methods used in introducing it into the hole. If cement or other plugs were used, state the character of same and depth placed, from \_\_\_\_\_ feet to \_\_\_\_\_ feet for each plug set.

Plugged with 50 sacks cement at 650'; 12 sacks cement, 1 sack hulls and plug at 40'.

RECEIVED  
STATE CORPORATION COMMISSION  
APR 17 1978  
4-17-78  
CONSERVATION DIVISION  
Wichita, Kansas

(If additional description is necessary, use BACK of this sheet)  
Name of Plugging Contractor Halliburton Cementing Co.  
Address 410 Union Center, Wichita, Kansas 67202

STATE OF KANSAS COUNTY OF SEDGWICK, ss.  
John D. Knightley (employee of owner) or (owner or operator) of the above-described

well, being first duly sworn on oath, says: That I have knowledge of the facts, statements, and matters herein contained and the log of the above-described well as filed and that the same are true and correct. So help me God.

(Signature) *John D. Knightley*  
221 S. Broadway, Wichita, Kansas  
(Address)

SUBSCRIBED AND SWORN TO before me this 12th day of April, 1978

My commission expires March 12, 1979. *Stella J. Lipp* Notary Public.

D. R. Lauck Oil Company, Inc. - Timmons "A" #1  
 20' N of C SW NW Sec. 6-31S-18W  
 Comanche County, Kansas

Contractor: D. R. Lauck Oil Company, Inc.  
 221 S. Broadway, Suite 400  
 Wichita, Kansas 67202

Commenced: 3-22-78  
 Completed: 4-7-78

Drillers Log

Sand & Shale	220
Shale	2120
Shale & Lime	2715
Shale	3015
Lime & Shale	3105
Shale & Lime	3830
Lime & Shale	3900
Shale & Lime	4175
Lime	5155 RTD

RECEIVED  
 STATE CORPORATION COMMISSION

APR 17 1978  
 4-17-78

CONSERVATION DIVISION  
 Wichita, Kansas