


STATE OF KANSAS  
STATE CORPORATION COMMISSION  
CONSERVATION DIVISION  
P. O. BOX 17027  
WICHITA, KANSAS 67217

FORM CP-4

WELL PLUGGING RECORD

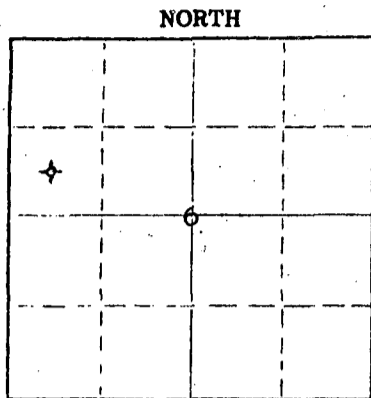

Locate well correctly on above Section Plot

Comanche County, Sec. 6 Twp 31S Rge 18W (W)  
Location as "NE/CNW/SW" or footage from lines C SW NW  
Lease Owner D. R. Lauck Oil Company, Inc.  
Lease Name Timmons Well No. 1  
Office Address 221 S. Broadway, Suite 400, Wichita, Kansas  
Character of Well (completed as Oil, Gas or Dry Hole) Lost circulation, skid rig.  
Date well completed March 21, 19 78  
Application for plugging filed March 21, 19 78  
Application for plugging approved March 21, 19 78  
Plugging commenced March 21, 19 78  
Plugging completed March 21, 19 78  
Reason for abandonment of well or producing formation Lost circulation, skid rig to 20' north.  
If a producing well is abandoned, date of last production 19\_\_\_\_  
Was permission obtained from the Conservation Division or its agents before plugging was commenced? Yes

Name of Conservation Agent who supervised plugging of this well William T. Owen  
Producing formation \_\_\_\_\_ Depth to top \_\_\_\_\_ Bottom \_\_\_\_\_ Total Depth of Well 657 Feet  
Show depth and thickness of all water, oil and gas formations.

OIL, GAS OR WATER RECORDS

CASING RECORD

FORMATION	CONTENT	FROM	TO	SIZE	PUT IN	PULLED OUT
		0	481'	8-5/8"	481'	None

Describe in detail the manner in which the well was plugged, indicating where the mud fluid was placed and the method or methods used in introducing it into the hole. If cement or other plugs were used, state the character of same and depth placed, from \_\_\_\_\_ feet to \_\_\_\_\_ feet for each plug set.

Spotted 3 sacks hulls and 75 sacks cement at 500',  
3 sacks hulls and 25 sacks cement at 60'.

RECEIVED  
STATE CORPORATION COMMISSION  
APR 17 1978  
4-17-78  
CONSERVATION DIVISION  
Wichita, Kansas

(If additional description is necessary, use BACK of this sheet)  
Name of Plugging Contractor Halliburton Cementing Company  
Address 410 Union Center, Wichita, Kansas 67202

STATE OF KANSAS COUNTY OF SEDGWICK ss.  
John D. Knightley

(employee of owner) or (owner or operator) of the above-described well, being first duly sworn on oath, says: That I have knowledge of the facts, statements, and matters herein contained and the log of the above-described well as filed and that the same are true and correct. So help me God.

(Signature) *John D. Knightley*  
221 S. Broadway, Wichita, Kansas  
(Address)

SUBSCRIBED AND SWORN TO before me this 12th day of April, 19 78

My commission expires March 12, 1979 Notary Public. *Stella J. Lipps*

D. R. Lauck Oil Company, Inc. - Timmons #1  
 C SW NW Sec. 6-31S-18W  
 Comanche County, Kansas

Contractor: D. R. Lauck Oil Company, Inc.  
 221 S. Broadway, Suite 400  
 Wichita, Kansas 67202

Commenced: 3-14-78  
 Completed: 3-21-78 (skid rig 20' north)

Drillers Log

Shale	40
Sand	73
Gyp Rock	111
Red Bed	225
Shale	317
Sand	365
Gyp	423
Shale	657 RTD

(Lost circulation, skid rig to Timmons "A" #1,  
 20' N of C SW NW Sec. 6-31S-18W.)

RECEIVED  
 STATE CORPORATION COMMISSION

APR 17 1978  
 4-17-78

CONSERVATION DIVISION  
 Wichita, Kansas