

15-033-20144-0000


STATE OF KANSAS  
STATE CORPORATION COMMISSION

Form CP-4

Give All Information Completely  
Make Required Affidavit  
Mail or Deliver Report to:  
Conservation Division  
State Corporation Commission

P. O. Box 17027  
Wichita, Kansas 67217  
NORTH

WELL PLUGGING RECORD

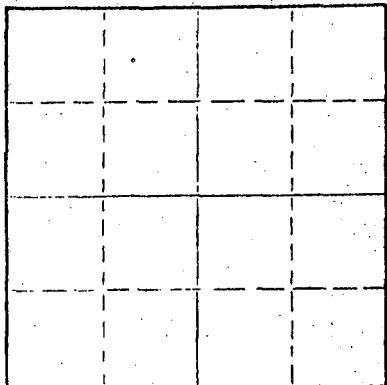

Locate well correctly on above  
Section Plat

Comanche County, Sec. 6 Twp. 31S Rge. (E) 18W  
Location as "NE/CNW/SW" or footage from lines C SE SE  
Lease Owner OKMAR OIL COMPANY  
Lease Name Burkhall Well No. 1-6  
Office Address 1130 Vickers/KSB&T Bldg., Wichita, Kansas  
Character of Well (completed as Oil, Gas or Dry Hole) Dry Hole  
Date well completed 5-16 1974  
Application for plugging filed 5-16 1974  
Application for plugging approved 5-16 1974  
Plugging commenced 5-16 1974  
Plugging completed 5-16 1974  
Reason for abandonment of well or producing formation No commercial quantities of oil or gas encountered.  
If a producing well is abandoned, date of last production 19  
Was permission obtained from the Conservation Division or its agents before plugging was commenced? Yes

Name of Conservation Agent who supervised plugging of this well G. R. Biberstein  
Producing formation \_\_\_\_\_ Depth to top \_\_\_\_\_ Bottom \_\_\_\_\_ Total Depth of Well 5245 Feet  
Show depth and thickness of all water, oil and gas formations.

OIL, GAS OR WATER RECORDS

CASING RECORD

FORMATION	CONTENT	FROM	TO	SIZE	PUT IN	PULLED OUT
Surface Hole	Water	Surface	473	13"	465'	None

Describe in detail the manner in which the well was plugged, indicating where the mud fluid was placed and the method or methods used in introducing it into the hole. If cement or other plugs were used, state the character of same and depth placed, from \_\_\_\_\_ feet to \_\_\_\_\_ feet for each plug set.

Fluid to 400', plug, 65 sx cement;  
Fluid to 40', plug, 20 sx cement;  
Two sacks cement in rat hole.

RECEIVED  
STATE CORPORATION COMMISSION  
MAY 21 1974  
5-21-74  
CONSERVATION DIVISION  
Wichita, Kansas

(If additional description is necessary, use BACK of this sheet)  
Name of Plugging Contractor D N B DRILLING, INC.  
Address 701 First Nat'l Bldg., Wichita, Kansas

STATE OF KANSAS, COUNTY OF \_\_\_\_\_, ss.  
JAMES L. DONELSON

(employee of owner) or (owner or operator) of the above-described well, being first duly sworn on oath, says: That I have knowledge of the facts, statements, and matters herein contained and the log of the above-described well as filed and that the same are true and correct. So help me God.

(Signature) James L. Donelson  
701 First Nat'l Bldg., Wichita, Kansas  
(Address)

SUBSCRIBED AND SWORN TO before me this 20th day of May, 1974

STATE NOTARY PUBLIC  
Ella Priess  
My Com. Expires Aug. 25, 1976

Ella Priess  
Notary Public.

My commission expires August 25, 1976

DRILLERS' LOG

OKMAR OIL COMPANY  
 No. 106 Burkhall  
 SE SE, Sec. 6-31S-18W  
 Comanche County, Kansas

Elevation: 2201 K.B.

Commenced: 5-2-74  
 Completed: 5-16-74

Surface Casing: 13" set  
 at 473' cemented w/250 sx  
 60-40 Posmix, 6% Gel, 2% cc.  
 + 75 sx 60-40 Posmix, 2% Gel,  
 2% cc. 5-4-74

FORMATIONDEPTH

Surface Hole	0 - 473
Red Bed & Sand	473 - 1147
Anhydrite	1147 - 1167
Shale	1167 - 1530
Shale & Lime	1530 - 2760
Lime & Shale	2760 - 3335
Shale & Lime	3335 - 3570
Lime & Shale	3570 - 4160
Lime	4160 - 5245 T.D.

RECEIVED  
 STATE CORPORATION COMMISSION  
 MAY 21 1974  
 S-21-74  
 CONSERVATION DIVISION  
 Wichita, Kansas

I do hereby certify that the foregoing statements are true and correct to the best of my knowledge and belief.

D N B DRILLING, INC.

*James L. Donelson*  
 JAMES L. DONELSON

STATE OF KANSAS: ss:

Subscribed and sworn to before me, the undersigned, a Notary Public in and for said state, this 20th day of May, 1974.

My Commission Expires:  
 August 25, 1976

*Ella Priess*  
 Ella Priess, Notary Public

*Ella Priess*  
 STATE NOTARY PUBLIC  
 Sedgwick County, Kansas  
 My Com. Expires Aug. 25, 1976