


STATE OF KANSAS
STATE CORPORATION COMMISSION

Form CP-4

Give All Information Completely
Make Required Affidavit
Mail or Deliver Report to:
Conservation Division
State Corporation Commission
212 No. Market
Wichita, Kansas 67202

WELL PLUGGING RECORD

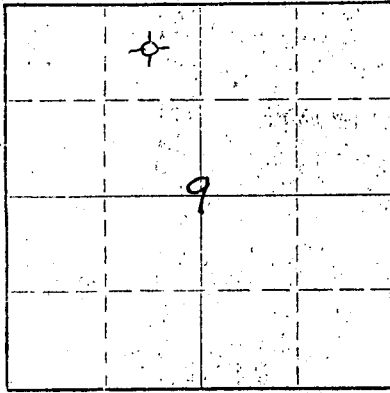

Locate well correctly on above
Section Plat

Comanche County, Sec. 9 Twp. 31 Rge. 18 (E) W (W)
Location as "NE/CNWSW" or footage from lines NE NW
Lease Owner Graham-Michaelis
Lease Name Uhl Well No. 4-9
Office Address Box 247, Wichita, Kansas 67201
Character of Well (completed as Oil, Gas or Dry Hole) Dry Hole
Date well completed June 12 1973
Application for plugging filed June 12 1973
Application for plugging approved June 12 1973
Plugging commenced June 12 1973
Plugging completed June 12 1973
Reason for abandonment of well or producing formation No productive zone

If a producing well is abandoned, date of last production _____ 19____
Was permission obtained from the Conservation Division or its agents before plugging was commenced? Yes

Name of Conservation Agent who supervised plugging of this well G. R. Biberstein
Producing formation _____ Depth to top _____ Bottom _____ Total Depth of Well 5150 Feet
Show depth and thickness of all water, oil and gas formations.

OIL, GAS OR WATER RECORDS

CASING RECORD

FORMATION	CONTENT	FROM	TO	SIZE	PUT IN	PULLED OUT
				8 5/8	655	-0-

Describe in detail the manner in which the well was plugged, indicating where the mud fluid was placed and the method or methods used in introducing it into the hole. If cement or other plugs were used, state the character of same and depth placed, from _____ feet to _____ feet for each plug set.

Gunned up pits forming heavy mud. Filled hole with heavy mud. Spotted 50 sacks cement at 680 feet. Filled hole with heavy mud and spotted 15 sacks cement at 45 feet to base of well cellar. Job complete at 10:30 PM June 12, 1973.

RECEIVED
STATE CORPORATION COMMISSION
JUN 27 1973
6-27-73
CONSERVATION DIVISION
Wichita, Kansas

(If additional description is necessary, use BACK of this sheet)
Name of Plugging Contractor Garvey Drilling Company
Address RFD #2, Great Bend, Kansas 67530

STATE OF Kansas, COUNTY OF Barton, ss.
Ben E. Unruh (employee of owner) or (~~owner or operator~~) of the above-described well, being first duly sworn on oath, says: That I have knowledge of the facts, statements, and matters herein contained and the log of the above-described well as filed and that the same are true and correct. So help me God. GARVEY DRILLING COMPANY

(Signature) Ben E. Unruh
Box 1164 Great Bend, Kansas
(Address)

SUBSCRIBED AND SWORN to before me this 25th day of June, 19 73

Richard W. Dunks
Notary Public.

Commission expires May 28, 1977

15-033-20132-0000

WELL LOG

COMPANY **Graham-Michaelis Corporation**

SEC. **9** T. **31S** R. **18W**

FARM **Uh1** NO. **4-9**

LOC. **NE NW**


TOTAL DEPTH **5150'**

COUNTY **Comanche, Kansas**

COMM. **6-1-73** COMP. **6-12-73**

CONTRACTOR **Garvey Drilling Company**

CASING **8 5/8" @ 655' w/400sx**

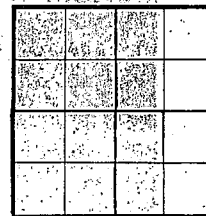

ELEVATION

PRODUCTION **D & A**

FIGURES INDICATE BOTTOM OF FORMATIONS

- 275' Surface Clay & Sand
- 620' Red Bed
- 1160' Red Bed & Shale
- 1263' Shale
- 1296' Anhydrite
- 1306' Shale
- 1875' Shale & Shells
- 2345' Shale
- 2495' Shale & Lime
- 3960' Lime & Shale
- 4642' Lime
- 4725' Lime & Shale
- 4787' Lime
- 4915' Lime & Shale
- 4980' Lime
- 5075' Mississippi
- 5115' Lime & Chert
- 5150' Lime
- 5150' RTD

RECEIVED
STATE CORPORATION COMMISSION
JUN 27 1973
6-27-73
CONSERVATION DIVISION
Wichita, Kansas

State of **Kansas** } ss
County of **Barton** }

I, **Charlene M. Marker** of **Garvey Drilling Company**

upon oath state the above and foregoing is a true and correct copy of the log of the **Uh1 No. 4-9** well.

Charlene M. Marker

Subscribed and sworn to before me this **13th** day of **June** 19 **73**

My Commission Expires: **April 14, 1975**

Arthur J. Mile
NOTARY PUBLIC