


WELL PLUGGING RECORD

Give All Information Completely  
Make Required Affidavit  
Mail or Deliver Report to:  
Conservation Division  
State Corporation Commission  
211 No. Broadway  
Wichita, Kansas

Comanche County, Sec. 9 Twp. 31S Rge. (E) 18 (W)

Location as "NE/CNW/SW" or footage from lines C NW/4 SE/4  
Lease Owner Graham-Michaelis Corporation  
Lease Name Uhl Well No. 2-9  
Office Address 211 North Broadway, Wichita, Kansas 67202  
Character of Well (completed as Oil, Gas or Dry Hole) Dry Hole  
Date well completed January 7, 1972  
Application for plugging filed January 7, 1972  
Application for plugging approved (verbal) January 7, 1972  
Plugging commenced January 7, 1972  
Plugging completed January 7, 1972  
Reason for abandonment of well or producing formation

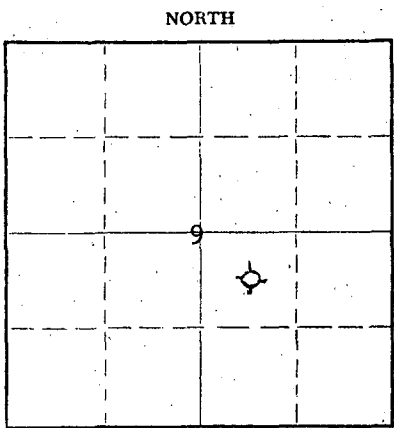

Locate well correctly on above Section Plat

If a producing well is abandoned, date of last production 19  
Was permission obtained from the Conservation Division or its agents before plugging was commenced? Yes (verbal)

Name of Conservation Agent who supervised plugging of this well G. R. Biberstein, Attica, Kansas  
Producing formation Depth to top Bottom Total Depth of Well 5130' Feet  
Show depth and thickness of all water, oil and gas formations.

OIL, GAS OR WATER RECORDS

CASING RECORD

FORMATION	CONTENT	FROM	TO	SIZE	PUT IN	PULLED OUT
				8 5/8"	578'	none

Describe in detail the manner in which the well was plugged, indicating where the mud fluid was placed and the method or methods used in introducing it into the hole. If cement or other plugs were used, state the character of same and depth placed, from feet to feet for each plug set.

Hole filled with heavy drilling mud to 550' then dumped 50 sacks cement. Filled hole with heavy drilling mud to 40' and dumped 10 sacks cement to surface.

RECEIVED  
STATE CORPORATION COMMISSION  
1-19-72  
JAN 19 1972  
CONSERVATION DIVISION  
Wichita, Kansas

(If additional description is necessary, use BACK of this sheet)  
Name of Plugging Contractor Garvey Drilling Company  
Address 300 West Douglas, Wichita, Kansas 67202

STATE OF Kansas, COUNTY OF Sedgwick, ss.

John L. James (employee of owner) of the above-described well, being first duly sworn on oath, says: That I have knowledge of the facts, statements, and matters herein contained and the log of the above-described well as filed and that the same are true and correct. So help me God.

(Signature) John L. James  
211 North Broadway, Wichita, Kansas 67202  
(Address)

SUBSCRIBED AND SWORN TO before me this 18th day of January, 1972

My commission expires

MURIEL F. C. JERAM  
NOTARY PUBLIC  
SEDGWICK COUNTY, KANSAS  
MY COMMISSION EXPIRES  
JULY 25, 1972

Muriel F. C. Jeram  
Notary Public.

15-033-20113-0000

# WELL LOG

COMPANY **Graham-Michaelis Corporation**

SEC. 9 T. 31S R. 18W

FARM **Uhl** NO. **2-9**

LOC. **C NW SE**


TOTAL DEPTH **5131'**

COUNTY **Comanche, Kansas**

COMM. **12-26-71** COMP. **1-8-72**

CONTRACTOR **Garvey Drilling Company**

CASING  
**8 5/8" @ 577' w/400sx**

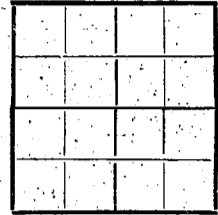

ELEVATION

PRODUCTION **D & A**

FIGURES INDICATE BOTTOM OF FORMATIONS

- 100' Sand
- 250' Shale & Sand
- 370' Red Bed
- 1775' Shale & Shells
- 2412' Shale & Lime
- 2458' Lime & Shale
- 4620' Lime
- 5131' Lime
- 5131' RTD

RECEIVED  
STATE CORPORATION COMMISSION  
1-19-72  
JAN 19 1972  
CONSERVATION DIVISION  
Wichita, Kansas

State of Kansas }  
County of Barton } ss

I, Charlene Marker of Garvey Drilling Company  
upon oath state the above and foregoing is a true and correct copy of the log of the Uhl 2-9 well.

Subscribed and sworn to before me this 12th day of January 19 72

My Commission Expires: July 8, 1974

*Charlene Marker*  
*George C. [Signature]*  
NOTARY PUBLIC