


WELL PLUGGING RECORD

Give All Information Completely
Make Required Affidavit
Mail or Deliver Report to:
Conservation Division
State Corporation Commission
211 No. Broadway
Wichita, Kansas

NORTH

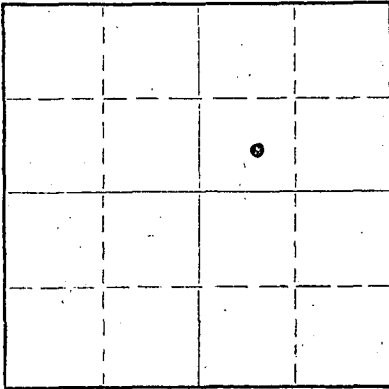

Locate well correctly on above
Section Plat

Barber County, Sec. 25 Twp. 30S Rge. (E) 11 (W)
Location as "NE/CNW&SW&" or footage from lines 150' E of C of SE-NE
Lease Owner Shenandoah Oil Corporation
Lease Name Lulu Sleeper Well No. 1
Office Address 1018 Commerce Bldg., Fort Worth, Texas
Character of Well (completed as Oil, Gas or Dry Hole) Oil
Date well completed July 10 19 67
Application for plugging filed December 13 19 67
Application for plugging approved December 15 19 67
Plugging commenced January 3 19 68
Plugging completed January 6 19 68
Reason for abandonment of well or producing formation Ceased to produce
oil in commercial quantities
If a producing well is abandoned, date of last production November 6 19 67
Was permission obtained from the Conservation Division or its agents before plugging was commenced? Yes

Name of Conservation Agent who supervised plugging of this well Mr. Archie Elving
Producing formation Simpson Sand Depth to top 4767 Bottom 4777 Total Depth of Well 4790 Feet
Show depth and thickness of all water, oil and gas formations.

OIL, GAS OR WATER RECORDS

CASING RECORD

FORMATION	CONTENT	FROM	TO	SIZE	PUT IN	PULLED OUT
Simpson Sand	Oil, gas & water	4742	4790	8-5/8 4 1/2	273 4790	None 3959.75

Describe in detail the manner in which the well was plugged, indicating where the mud fluid was placed and the method or methods used in introducing it into the hole. If cement or other plugs were used, state the character of same and depth placed, from - feet to - feet for each plug set.

Ripped pipe at 4070 and 4010-3950'.
Pulled 4 1/2" casing
Bailed hole down to 250 feet.
Plugged well with wood bridge at 250 feet.
10 feet of rock from 250 feet to 240 feet.
25 sacks of cement from 240 feet 165 feet.
Mud from 165 feet to 40 feet.
Rock from 40 feet to 30 feet.
10 sacks of cement from 30 feet to top of 8-5/8" surface casing.


RECEIVED
STATE CORPORATION COMMISSION
1-16-68
JAN 16 1968
CONSERVATION DIVISION
Wichita, Kansas

(If additional description is necessary, use BACK of this sheet)
Name of Plugging Contractor Clarke Corporation
Address Medicine Lodge, Kansas

STATE OF Texas, COUNTY OF Tarrant, ss.
Harold E. Burke (employee of owner) or (owner or operator) of the above-described well, being first duly sworn on oath, says: That I have knowledge of the facts, statements, and matters herein contained and the log of the above-described well as filed and that the same are true and correct. So help me God.

(Signature) Harold E. Burke
1018 Commerce Bldg., Fort Worth, Texas
(Address)

SUBSCRIBED AND SWORN to before me this 15th day of January, 1968

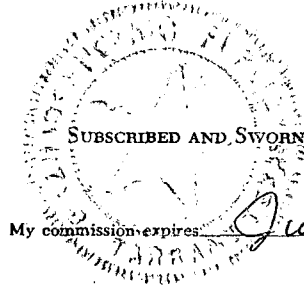

Jerry Robbins
Notary Public.

WELL LOG
 Sleeper #1
 C. SE NW 25-30S-11W
 Barber County, Kansas

<u>FROM</u>	<u>TO</u>		<u>Formation Tops:</u>	
0	60	Sand	Elgin	3538'
60	800	Red Bed	Heeb.	3666'
800	1395	Shale	Tor.	3710'
1395	1475	Shale & Lime	Doug. Sh.	3746'
1475	2565	Lime & Shale	Doug. Sd.	3792'
2565	3869	Shale & Lime	B.L.	3840'
3869	4415	Lime	Lan.	3854'
4415	4470	Miss. Lime	B K C	4238'
4470	4689	Shale & Lime	Miss.	4406'
4689	4750	Viola Lime	Kind	4492'
4750	4790	Simpson Sand	Chattasona	4640'
4790		Total Depth	Viola	4668'
			Simp. Sh.	4742'
			Simp. Sd.	4746'
			T.D.	4790'

STATE OF KANSAS

COUNTY OF BARTON ss

T. D. Sweetman, Partner of S & S Drilling Company, being first duly sworn on oath says: That I have knowledge of the facts, statements and matters herein contained and the log of the above described well as filed and that the same are true and correct.

T. D. Sweetman
 T. D. Sweetman

Subscribed and sworn before me this 20th day of December, 1966

Beata L. Boyd
 Notary Public Barton County

My Commission Expires 5/9/67

RECEIVED
 STATE CORPORATION COMMISSION
 1-18-68
 JAN 18 1968
 CONSERVATION DIVISION
 Wichita, Kansas