


STATE OF KANSAS
STATE CORPORATION COMMISSION

WELL PLUGGING RECORD

Give All Information Completely
Make Required Affidavit
Mail or Deliver Report to
Conservation Division
State Corporation Comm.
245 North Water
Wichita, KS 67202

Barber County. Sec. 5 Twp. 30 Rge. 13W E/W
Location as "NE/CNW $\frac{1}{4}$ SW $\frac{1}{4}$ " or footage from lines
2310' FSL & 2310' FEL
Lease Owner Texas Oil & Gas Corp.
Lease Name Knackstedt Estate Well No. 1
Office Address 200 W. Douglas-Suite 300, Wichita, KS
Character of Well (Completed as Oil, Gas or Dry Hole) 67202
Dry Hole
Date Well completed February 16, 19 80
Application for plugging filed Verbal Application 19
Application for plugging approved Verbal Approval 19
Plugging commenced February 16, 19 80
Plugging completed February 16, 19 80
Reason for abandonment of well or producing formation

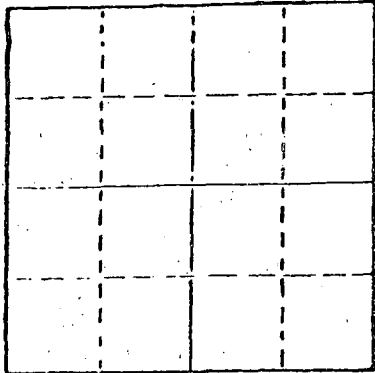

Locate well correctly on above
Section Plot

If a producing well is abandoned, date of last production 19

Was permission obtained from the Conservation Division or
its agents before plugging was commenced? Yes

Name of Conservation Agent who supervised plugging of this well William T. Owen
Producing formation Depth to top Bottom Total Depth of Well 4,719'
Show depth and thickness of all water, oil and gas formations.

OIL, GAS OR WATER RECORDS

CASING RECORD

FORMATION	CONTENT	FROM	TO	SIZE	PUT IN	PULLED OUT
				10-3/4"	290'	None

Describe in detail the manner in which the well was plugged, indicating where the mud fluid
was placed and the method or methods used in introducing it into the hold. If cement or other
plugs were used, state the character of same and depth placed, from feet to
feet for each plug set.

Filled hole with heavy rotary mud from 4,719 ft. (rotary total depth) to
370 ft. Set plug at 370 ft. and cemented with 50 sacks cement. Filled
hole with heavy rotary mud from 370 ft. to 40 ft. Set solid plug at 40 ft.
and cemented to cellar with 20 sacks cement, 5 sacks cement in rat hole.

Plugging operations accomplished utilizing Halliburton Oil Well cementing
pump truck through 4 1/2 inch drill pipe.

(If additional description is necessary, use BACK of this sheet)

Name of Plugging Contractor Halliburton Services
410 Union Center Bldg., Wichita, Kansas 67202

STATE OF Kansas COUNTY OF Sedgwick, ss.
Dean Britting, Agent (Agent of owner or operator)


of the above-described well, being first duly sworn on oath, says: That I have knowledge of
the facts, statements, and matters herein contained and the log of the above-described well
as filed and that the same are true and correct. So help me God.

(Signature) Dean Britting
200 N. Main, Wichita, Kansas 67202
(Address)

SUBSCRIBED AND SWORN TO before me this 20th day of February, 1980

Elsie Willison Notary Public.
Wichita, Kansas

My commission expires July 25, 1982

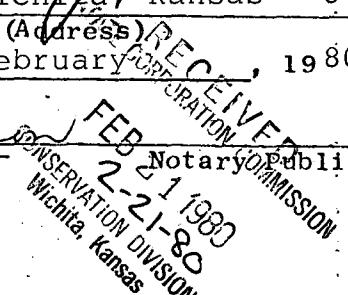

KANSAS DRILLERS LOG

COMPANY Texas Oil & Gas Corp.

SEC. 5 T. 30 R. 13W
LOC. 2310' FSL & 2310' FEL

FARM Knackstedt Estate NO. 1

COUNTY Barber

ROTARY TOTAL DEPTH 4,719'
COMM. February 3, 1980 COMP. February 16, 1980
CONTRACTOR H-30, INC. (Rig #5)
ISSUED February 20, 1980

CASING

10 3/4" Set at 290' cemented w/300 sxs cement
8 5/8"
5 1/2"
4 1/2"

ELEVATION 1,945' R.B.

FIGURES INDICATE BOTTOM OF FORMATIONS

Sand, Shale and Red Bed	305'
Red Bed and Shale	1,005'
Shale and Red Bed	2,060'
Lime and Shale	2,310'
Shale and Lime	2,831'
Lime and Shale	3,025'
Shale and Lime	3,625'
Lime and Shale	3,805'
Shale and Lime	4,190'
Lime and Shale	4,327'
Shale and Lime	4,443'
Lime and Shale	4,565'
Shale and Lime	4,616'
Lime and Shale	4,648'
Lime	4,659'
Shale and Lime	4,704'
Lime and Shale	4,719'
Rotary Total Depth	4,719'

I hereby certify the above and foregoing to be a true and correct log of the above described well as shown by the drilling reports.

H-30, INC.

Dean Britting
Dean Britting

RECEIVED
STATE CORPORATION COMMISSION
FEB 21 1980
CONSERVATION DIVISION
Wichita, Kansas

State of Kansas)
) ss:
County of Sedgwick)

Subscribed and Sworn to before me a Notary Public
in and for said county and state this 20th day of
February, 1980.

WILLISON
NOTARY

Elsie Willison
Elsie Willison - Notary Public

My Commission Expires:
July 25, 1982