

STATE OF KANSAS
STATE CORPORATION COMMISSION


Give All Information Completely
Make Required Affidavit
Mail or Deliver Report to:
Conservation Division
State Corporation Commission
11 No. Broadway
Wichita, Kansas

WELL PLUGGING RECORD

Barber County, Sec. 5 Twp. 30 Rge. 13 (W)

Location as "NE/CNW/SW" or footage from lines Ctr. NE SE
Lease Owner Graybol Oil Corporation
Lease Name Lambert Well No. 1
Office Address 2200 N. B. T. Bldg., Tulsa 3, Oklahoma
Character of Well (completed as Oil, Gas or Dry Hole) Dry Hole
Date well completed September 4 19 63
Application for plugging filed September 4 19 63
Application for plugging approved September 4 19 63
Plugging commenced September 4 19 63
Plugging completed September 4 19 63
Reason for abandonment of well or producing formation Dry Hole

NORTH

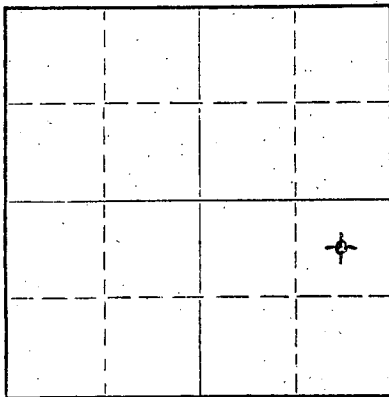

Locate well correctly on above
Section Plat

If a producing well is abandoned, date of last production _____ 19____
Was permission obtained from the Conservation Division or its agents before plugging was commenced? Yes

Name of Conservation Agent who supervised plugging of this well Archie V. Elving
Producing formation None Depth to top _____ Bottom _____ Total Depth of Well 4800' Feet
Show depth and thickness of all water, oil and gas formations.

OIL, GAS OR WATER RECORDS

CASING RECORD

FORMATION	CONTENT	FROM	TO	SIZE	PUT IN	PULLED OUT
Lansing Lime	Water	3992	4387	8 5/8"	461'	None
Mississippian Lime	Tight	4474	4496			
Viola Lime	Water	4540	4646			
Simpson Sand	Water	4654	4687			
Arbuckle Lime	Water	4739	4800			

Describe in detail the manner in which the well was plugged, indicating where the mud fluid was placed and the method or methods used in introducing it into the hole. If cement or other plugs were used, state the character of same and depth placed, from _____ feet to _____ feet for each plug set.

Filled hole with heavy mud-laden fluid to 300'. Placed one-quarter sack of hulls and 20 sacks of Portland cement in hole. Filled hole with heavy mud-laden fluid to 40'. Placed in one-quarter sack of hulls. Cemented with ten sacks of Portland cement from 40' to ground level.

RECEIVED
STATE CORPORATION COMMISSION

SEP 10 1963

9-10-63

CONSERVATION DIVISION
Wichita, Kansas

(If additional description is necessary, use BACK of this sheet)

Name of Plugging Contractor None used.
Address _____

STATE OF OKLAHOMA COUNTY OF Tulsa, ss.
Lyman C. Dennis (employee of owner) or (owner) of the above-described well, being first duly sworn on oath, says: That I have knowledge of the facts, statements, and matters herein contained and the log of the above-described well as filed and that the same are true and correct. So help me God.

(Signature) Lyman C. Dennis

Tulsa, Oklahoma
(Address)

SUBSCRIBED AND SWORN TO before me this 9th day of September, 19 63

My commission expires October 8, 1966
Jan Carrigan Notary Public.



GRAYBOL OIL CORPORATION

Barber County, Kansas

No. 1 Lambert

Ctr. NE SE Section 5-30S-13W

Contractor: Company Tools

Elev: 1922 K.B., 1916 G.L. (L-S)

Commenced: August 16, 1963

Completed: September 4, 1963

Production: Dry & Abandoned

CASING RECORD

Set 8 5/8" Casing @ 461' with 275 sacks of pozmix cement.

DEPTH	FORMATION	ELECTRA INC. ELECTRIC LOG TOPS:
0-30	Topsoil	Stone Corral Anhydrite 800
30-190	Sand	Heebner Shale 3794
190-395	Red beds, shale and sand	Toronto Limestone 3811
395-695	Shells and sand	Douglas Sandstone 3858
695-985	Red beds	Lansing Limestone 3992
985-1447	Shale	Base of Kansas City 4387
1447-1950	Shale and shells	Marmaton Limestone 4394
1950-2083	Shale and lime	Mississippian Chert 4474
2083-2270	Lime	Kinderhook Shale 4496
2270-2385	Lime and shale	Viola Limestone 4540
2385-2460	Lime	Simpson Shale 4646
2460-2655	Lime and shale	Simpson Sand 4654
2655-2675	Lime	Arbuckle Limestone 4739
2675-3185	Shale and lime	Log Total Depth 4797
3185-3235	Lime	
3235-3335	Lime and Shale	
3335-3419	Shale and lime	
3419-3605	Lime and Shale	
3605-3752	Shale and lime	
3752-3878	Lime, sand and shale	
3878-3952	Sand and shale	
3952-4464	Lime	
4464-4504	Chert and lime	
4504-4522	Lime	
4522-4574	Lime and Shale	
4574-4635	Lime	
4635-4666	Lime and chert	
4666-4706	Sand and shale	
4706-4737	Sand, shale and chert	
4737-4757	Chert	
4757-4800	Lime and chert	

RECEIVED
STATE CORPORATION COMMISSION

SEP 10 1963
9-10-63
CONSERVATION DIVISION
Wichita, Kansas

I hereby certify that the above is a true and correct log of the above captioned well as taken directly from the daily reports.

GRAYBOL OIL CORPORATION

By: Lyman C. Dennis
Lyman C. Dennis, Geologist

STATE OF OKLAHOMA
COUNTY OF TULSA

Subscribed and sworn to this 9th day of September, 1963.

Jan Carrigan
Jan Carrigan, Notary Public

My commission expires: October 8, 1966