


STATE OF KANSAS
STATE CORPORATION COMMISSION

Give All Information Completely
Make Required Affidavit
Mail or Deliver Report to:
Conservation Division
State Corporation Commission
212 No. Market
Wichita, Kansas 67202

NORTH

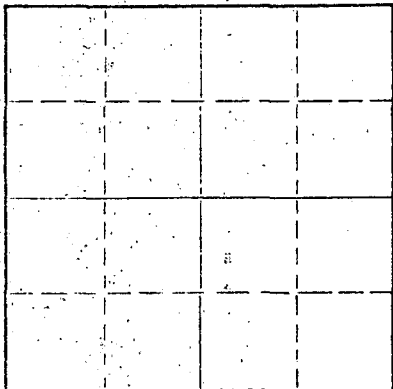

Locate well correctly on above
Section Plat

WELL PLUGGING RECORD

15-159-19289-0001
Form CP-4

Rice County. Sec. 5 Twp. 20 Rge. 8 (E) (W) x
Location as "NE/CNW/SW" or footage from lines 1893' FNL - 833' FWL NW/4
Lease Owner Kewanee Oil Co.
Lease Name West Lyons Unit (DE WITTE) Well No. 37-2
Office Address Box 360 Holsington, Kansas
Character of Well (completed as Oil, Gas or Dry Hole)
Date well completed 19
Application for plugging filed 19
Application for plugging approved 19
Plugging commenced 2-19-72 19
Plugging completed 2-22-72 19
Reason for abandonment of well or producing formation
If a producing well is abandoned, date of last production 19
Was permission obtained from the Conservation Division or its agents before plugging was commenced?

Name of Conservation Agent who supervised plugging of this well Gilbert Toman
Producing formation Depth to top Bottom Total Depth of Well 3300' Feet
Show depth and thickness of all water, oil and gas formations.

OIL, GAS OR WATER RECORDS

CASING RECORD

FORMATION	CONTENT	FROM	TO	SIZE	PUT IN	PULLED OUT
				4 1/2"	3299'	2508'72'
				8 5/8"	205'	

Describe in detail the manner in which the well was plugged, indicating where the mud fluid was placed and the method or methods used in introducing it into the hole. If cement or other plugs were used, state the character of same and depth placed, from feet to feet for each plug set.

Pumped 20 sacks cement from 3120' to 3300'.
Mudded hole to 235' - set 15' rock bridge. Filled hole with 3 1/2 yards of ready-mix concrete to base of cellar

RECEIVED
STATE CORPORATION COMMISSION
MAR 10 1972
CONSERVATION DIVISION
Wichita, Kansas

(If additional description is necessary, use BACK of this sheet)

Name of Plugging Contractor Southwest Casing Pulling Co.
Address Box 364 Great Bend, Kansas

STATE OF Kansas, COUNTY OF Barton, ss.

Southwest Casing Pulling Co. (employee of owner) or (owner or operator) of the above-described well, being first duly sworn on oath, says: That I have knowledge of the facts, statements, and matters herein contained and the log of the above-described well as filed and that the same are true and correct. So help me God.

(Signature) W. C. Spencer Sec.
Box 364 Great Bend, Kansas
(Address)

SUBSCRIBED AND SWORN to before me this 9 day of March, 1972

My commission expires October 1972


Notary Public.

STATE OF KANSAS
STATE CORPORATION COMMISSION

Form CP-4

Give All Information Completely
Make Required Affidavit
Mail or Deliver Report to:
Conservation Division
State Corporation Commission
212 No. Market
Wichita, Kansas 67202

WELL PLUGGING RECORD

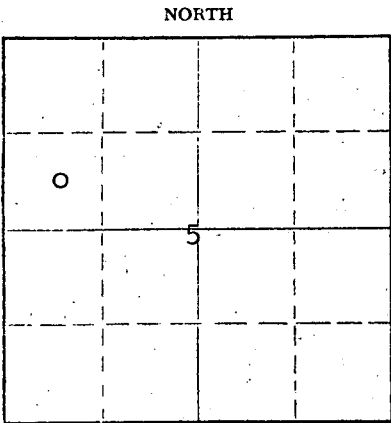

Locate well correctly on above
Section Plat

Rice County, Sec. 5 Twp. 20 Rge. 8 (E) (W) X
Location as "NE/CNW&SW" or footage from lines 1893' FNL, 833' FWL NW/4
Lease Owner Kewanee Oil Company
Lease Name West Lyons Unit Well No. 37-2 WI
Office Address Box 360, Hoisington, Kansas
Character of Well (completed as Oil, Gas or Dry Hole) Oil
Date well completed 8-20-64
Application for plugging filed 1-12-72
Application for plugging approved 1-13-72
Plugging commenced 2-19-72
Plugging completed 2-22-72
Reason for abandonment of well or producing formation? No longer of benefit to flood as water input.
If a producing well is abandoned, date of last production 19
Was permission obtained from the Conservation Division or its agents before plugging was commenced? Yes

Name of Conservation Agent who supervised plugging of this well Gilbert Toman
Producing formation Kinderhook Depth to top 3248 Bottom Total Depth of Well 3300' Feet
Show depth and thickness of all water, oil and gas formations.

OIL, GAS OR WATER RECORDS

CASING RECORD

FORMATION	CONTENT	FROM	TO	SIZE	PUT IN	PULLED OUT
				4-1/2"	3299	2508.72'
				8-5/8"	205	None

Describe in detail the manner in which the well was plugged, indicating where the mud fluid was placed and the method or methods used in introducing it into the hole. If cement or other plugs were used, state the character of same and depth placed, from feet to feet for each plug set.

Pumped 20 sacks cement from 3120-3300'.
Mudded hole to 235', set 15' rock bridge.
Filled hole with 3-1/2 yards of ready-mix concrete to base of cellar.

RECEIVED
STATE CORPORATION COMMISSION
MAR 31 1972
CONSERVATION DIVISION
Wichita, Kansas

(If additional description is necessary, use BACK of this sheet)
Name of Plugging Contractor Southwest Casing Pulling Company
Address Box 364, Great Bend, Kansas

STATE OF Kansas, COUNTY OF Sedgwick, ss.
C. W. Mosier (employee of owner) or former owner of the above-described well, being first duly sworn on oath, says: That I have knowledge of the facts, statements, and matters herein contained and the log of the above-described well as filed and that the same are true and correct. So help me God.

(Signature)

Box 2093, Wichita, Kansas 67201
(Address)

SWORN TO before me this 30th day of March, 1972

My commission expires 8-10-75

Billie Oden

Notary Public.

AMERICAN OIL & GAS CO.
809 Bitting Bldg.
Wichita, Kansas


RECEIVED
STATE CORPORATION COMMISSION
JAN 13 1972
CONSERVATION DIVISION
Wichita, Kansas

Well: DeWitte #2
Commenced R.D.: 8/11/64
Completed R.D.: 8/20/64
Total Depth: 3,300' D.F.
Casing: 205' of 8 5/8" 8 rd. thd.
3,300' of 4 1/4" Oil String
4 1/2"


Sec. C SW NW 5-20-8
Rice County, Kansas
Elevation:
Initial Prod:
Contractor: BURT DRILLING
COMPANY

Strata	Depth
Shale & sand	0- 75'
Sand w/shale	75- 90
Sand & shale	90- 130
Shale & redbed	130- 238
Anhydrite	238- 252
Shale & shells	252-1080
Shale & lime streaks	1080-1555
Shale & lime	1555-1780
Shale w/lime streaks	1780-2420
Lime	2420-2706
Shale (Heebner)	2706-2710
Lime & Shale (Toronto 2729)	2710-2841
Lime	2841-3175
Lime & shale	3175-3220
Lime & Conglomerate	3220-3251
Core	3251-3278
Shale	3278-3300

I hereby certify that the above is a true and correct log of said well
as reflected by daily reports.

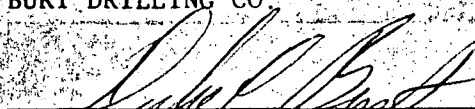BURT DRILLING CO.


Signed and sworn to in my presence this 22nd day of August, 1964.

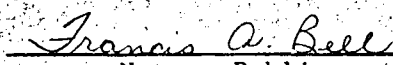
Notary Public

My Commission Expires: April 2, 1968

