


STATE OF KANSAS
STATE CORPORATION COMMISSION

Give All Information Completely
Make Required Affidavit
Mail or Deliver Report to:
Conservation Division
State Corporation Commission
211 No. Broadway
Wichita, Kansas

15-159-03669-0000
WELL PLUGGING RECORD

NORTH

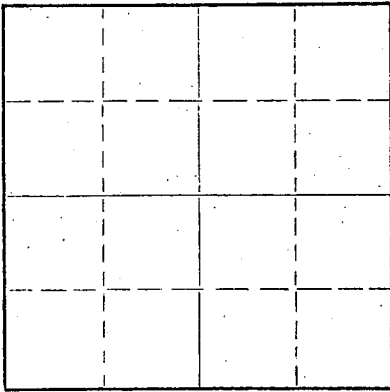

Locate well correctly on above
Section Plat

Rice County, Sec. 5 Twp. 20S Rge. (E) 8 (W)
Location as "NE/CNW/SE/SW" or footage from lines. 762' SL, 762' EL of NE/4
Lease Owner O. A. Sutton
Lease Name Aten Well No. 2
Office Address 407 Insurance Building, Wichita, Kansas
Character of Well (completed as Oil, Gas or Dry Hole) Dry Hole
Date well completed July 17 19 64
Application for plugging filed July 17 19 64
Application for plugging approved July 17 19 64
Plugging commenced July 17 19 64
Plugging completed July 17 19 64
Reason for abandonment of well or producing formation

If a producing well is abandoned, date of last production 19
Was permission obtained from the Conservation Division or its agents before plugging was commenced? Yes

Name of Conservation Agent who supervised plugging of this well Gilbert Toman
Producing formation Depth to top Bottom Total Depth of Well 3385 Feet
Show depth and thickness of all water, oil and gas formations.

OIL, GAS OR WATER RECORDS

CASING RECORD

FORMATION	CONTENT	FROM	TO	SIZE	PUT IN	PULLED OUT
				8-5/8"	206	

Describe in detail the manner in which the well was plugged, indicating where the mud fluid was placed and the method or methods used in introducing it into the hole. If cement or other plugs were used, state the character of same and depth placed, from feet to feet for each plug set.

Bottom plug at 200', plug hulls and 25 sacks cement. Filled with mud to 40'; plug hulls and 10 sacks cement to bottom of cellar.

RECEIVED
STATE CORPORATION COMMISSION

JUL 23 1964

CONSERVATION DIVISION
Wichita, Kansas

(If additional description is necessary, use BACK of this sheet)

Name of Plugging Contractor Gabbert-Jones Inc.
Address 514 Orpheum Building, Wichita, Kansas

STATE OF KANSAS, COUNTY OF SEDGWICK, ss.
E. E. Wible (employee of owner) or (owner or operator) of the above-described well, being first duly sworn on oath, says: That I have knowledge of the facts, statements, and matters herein contained and the log of the above-described well as filed and that the same are true and correct. So help me God.

(Signature) E. E. Wible
E. E. Wible
407 Insurance Building, Wichita, Kansas
(Address)

SUBSCRIBED AND SWORN to before me this 22nd day of July, 1964

My commission expires June 28, 1966.

Jean S. Taylor
Jean S. Taylor Notary Public.



GABBERT-JONES INC.
WICHITA, KANSAS
DRILLERS WELL LOG

#2 ATEN
C SE NE SECTION 5-20S-8W
RICE COUNTY, KANSAS

COMMENCED: JULY 10, 1964
COMPLETED: JULY 17, 1964

OPERATOR - O. A. SUTTON

RECEIVED
STATE CORPORATION COMMISSION

JUL 23 1964

CONSERVATION DIVISION
Wichita, Kansas

DEPTH		FORMATION	REMARKS
FROM	To		
0	50	SAND	
50	206	RED BED	RAN 10 JOINTS 8-5/8" CASING, SET @ 206' W/ 195 SACKS CEMENT
206	480	SHALE & SHELLS	
480	1505	LIME & SHALE	
1505	1650	LIME W/ SHALE STREAKS	
1650	1810	LIME	
1810	2530	LIME & SHALE	
2530	3310	LIME	
3310	3365	SAND & SHALE	
3365	3385	LIME	
3385	TD		DRY & ABANDONED

I, E. E. HALL, CERTIFY THIS IS A CORRECT COPY OF THE DRILLER'S LOG FOR THE WELL
DRILLED IN C SE NE SECTION 5-20S-8W, TO THE BEST OF MY KNOWLEDGE AND BELIEF.



E. E. HALL

STATE OF KANSAS)
) SS
COUNTY OF SEDGWICK)

BEFORE ME, THE UNDERSIGNED, A NOTARY PUBLIC WITHIN AND FOR SAID COUNTY AND STATE
ON THIS 21ST DAY OF JULY, 1964, PERSONALLY APPEARED E. E. HALL TO ME PERSONALLY KNOWN
TO BE THE IDENTICAL PERSON WHO EXECUTED THE WITHIN AND FOREGOING INSTRUMENT AND ACKNOWLEDGED
TO ME THAT HE EXECUTED THE SAME AS HIS FREE AND VOLUNTARY ACT AND DEED FOR THE USES AND
PURPOSES THEREIN SET FORTH.

IN WITNESS WHEREOF, I HAVE HEREUNTO SET MY HAND AND OFFICIAL SEAL THE DAY AND
YEAR LAST ABOVE WRITTEN.


VIRA A. MCKENZIE, NOTARY PUBLIC

MY COMMISSION EXPIRES OCTOBER 2, 1967