


STATE OF KANSAS  
STATE CORPORATION COMMISSION

Give All Information Completely  
Make Required Affidavit  
Mail or Deliver Report to:  
Conservation Division  
State Corporation Commission  
212 No. Market  
Wichita, Kansas 67202

NORTH

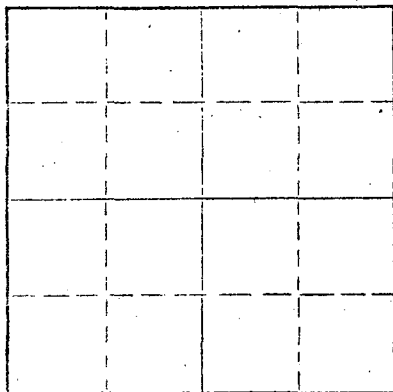

Locate well correctly on above  
Section Plat

Name of Conservation Agent who supervised plugging of this well Gilbert Toman  
Producing formation \_\_\_\_\_ Depth to top \_\_\_\_\_ Bottom \_\_\_\_\_ Total Depth of Well: 3290' Feet  
Show depth and thickness of all water, oil and gas formations.

OIL, GAS OR WATER RECORDS

CASING RECORD

| FORMATION | CONTENT | FROM | TO | SIZE   | PUT IN | PULLED OUT |
|-----------|---------|------|----|--------|--------|------------|
|           |         |      |    | 5 1/2" | 3289'  | 2548.84'   |
|           |         |      |    | 8 5/8" | 195'   |            |
|           |         |      |    |        |        |            |
|           |         |      |    |        |        |            |
Describe in detail the manner in which the well was plugged, indicating where the mud fluid was placed and the method or methods used in introducing it into the hole. If cement or other plugs were used, state the character of same and depth placed, from \_\_\_\_\_ feet to \_\_\_\_\_ feet for each plug set.

Made bottom hole plug back with sand to 3225'. Mixed and ran 5 sacks cement thru dump  
bailer.  
Mudded hole to 225', set 15' rock bridge. Filled hole with 3 1/2 yards ready-mix to  
base of cellar.

RECEIVED  
STATE CORPORATION COMMISSION

MAR 10 1972

CONSERVATION DIVISION  
Wichita, Kansas


Name of Plugging Contractor Southwest Casing Pulling Co. (If additional description is necessary, use BACK of this sheet)  
Address Box 364 Great Bend, Kansas

STATE OF Kansas, COUNTY OF Barton, ss.  
Southwest Casing Pulling Co. (employee of owner) or (owner or operator) of the above-described  
well, being first duly sworn on oath, says: That I have knowledge of the facts, statements, and matters herein contained and the log of the  
above-described well as filed and that the same are true and correct. So help me God.

(Signature) W. C. Spencer Sec  
Box 364 Great Bend, Kansas  
(Address)

SUBSCRIBED AND SWORN to before me this 24 day of February, 19 72

My commission expires

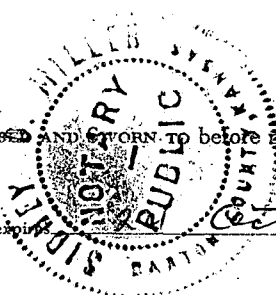


Sidney D. Miller  
Notary Public.

STATE OF KANSAS  
STATE CORPORATION COMMISSION

Form CP-4

Give All Information Completely  
Make Required Affidavit  
Mail or Deliver Report to:  
Conservation Division  
State Corporation Commission  
212 No. Market  
Wichita, Kansas 67202

WELL PLUGGING RECORD

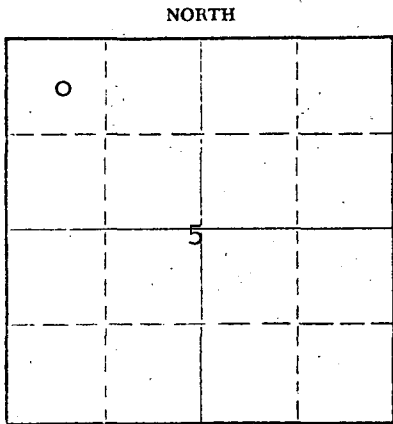

Locate well correctly on above  
Section Plat

Rice County. Sec. 5 Twp. 20 Rge. 8 (E) (W)  
Location as "NE/CNW/SW" or footage from lines NW NW NW  
Lease Owner Kewanee Oil Company  
Lease Name West Lyons Unit Well No. 37-1  
Office Address Box 360, Hoisington, Kansas  
Character of Well (completed as Oil, Gas or Dry Hole) Oil  
Date well completed 5-22- 1964  
Application for plugging filed 1-12- 1972  
Application for plugging approved 1-13- 1972  
Plugging commenced 2-16- 1972  
Plugging completed 2-18- 1972  
Reason for abandonment of well or producing formation Dry  
If a producing well is abandoned, date of last production 2-12- 1970  
Was permission obtained from the Conservation Division or its agents before plugging was commenced? Yes

Name of Conservation Agent who supervised plugging of this well Gilbert Toman  
Producing formation Kinderhook Depth to top 3241 Bottom Total Depth of Well 3290 Feet  
Show depth and thickness of all water, oil and gas formations.

OIL, GAS OR WATER RECORDS

CASING RECORD

| FORMATION | CONTENT | FROM | TO | SIZE   | PUT IN | PULLED OUT |
|-----------|---------|------|----|--------|--------|------------|
|           |         |      |    | 8-5/8" | 195    | None       |
|           |         |      |    | 5-1/2" | 3289   | 2548.84'   |
|           |         |      |    |        |        |            |
|           |         |      |    |        |        |            |
Describe in detail the manner in which the well was plugged, indicating where the mud fluid was placed and the method or methods used in introducing it into the hole. If cement or other plugs were used, state the character of same and depth placed, from feet to feet for each plug set.

Made bottom hole plug back with sand to 3225'. Mixed and ran 5 sacks cement thru dump bailer. Mudded hole to 225', set 15' rock bridge. Filled hole with 3-1/2 yards ready-mix to base of cellar.

RECEIVED  
STATE CORPORATION COMMISSION  
MAR 31 1972  
CONSERVATION DIVISION  
Wichita, Kansas

(If additional description is necessary, use BACK of this sheet)  
Name of Plugging Contractor Southwest Casing Pulling Company  
Address Box 364, Great Bend, Kansas

STATE OF Kansas, COUNTY OF Sedgwick, ss.  
C. W. Mosier (employee of owner) or owner or operator of the above-described well, being first duly sworn on oath, says: That I have knowledge of the facts, statements, and matters herein contained and the log of the above-described well, as filed and that the same are true and correct. So help me God.

(Signature)

Box 2093, Wichita, Kansas  
(Address)

Subscribed and sworn to before me this 30th day of March, 1972

My commission expires 8-10-75

Billie Oden

Notary Public.

AMERICAN OIL & GAS CO.  
809 Bitting Bldg.  
Wichita, Kansas

RECEIVED  
STATE CORPORATION COMMISSION  
JAN 13 1972  
CONSERVATION DIVISION  
Wichita, Kansas

Well: DeWitte No. 1  
Commenced R.D.: 5/13/64  
Completed R.D.: 5/22/64  
Total Depth: 3,290' D.F.  
Casing: 205' of 8 5/8" 24# 8rd. thd.  
3,290' of 5 1/2" Oil String

Sec.  
Rice County, Kansas  
Elevation:  
Initial Prod:  
Contractor: BURT DRILLING  
COMPANY

| Strata                  | Depth      |
|-------------------------|------------|
| Shale & Sand            | 0- 100     |
| Sand                    | 100- 121   |
| Shale                   | 129- 205   |
| Redbed                  | 205- 236   |
| Anhydrite               | 236- 255   |
| Shale & shells          | 255- 1090  |
| Lime with Shale streaks | 1090- 1230 |
| Lime                    | 1230- 1500 |
| Lime with Shale streaks | 1500- 1675 |
| Shale with Lime streaks | 1675- 2320 |
| Lime & Shale            | 2320- 2415 |
| Lime                    | 2415- 2713 |
| Shale with Lime Shells  | 2713- 2837 |
| Lime (Brown)            | 2837- 2870 |
| Shale                   | 2870- 2874 |
| Lime (Lansing)          | 2874- 2945 |
| Lime                    | 2945- 3170 |
| Lime & Shale            | 3170- 3247 |
| Coring                  | 3247- 3257 |
| Shale                   | 3257- 3290 |

I hereby certify that the above is a true and correct log of said well as reflected by daily reports.

BURT DRILLING CO.



Signed and sworn to in my presence this 1st day of June, 1964

Notary Public

My Commission Expires: April 2, 1968