

15-159-20299-0000

STATE OF KANSAS
STATE CORPORATION COMMISSION


Form CP-4

WELL PLUGGING RECORD

Give All Information Completely
Make Required Affidavit
Mail or Deliver Report to:
Conservation Division
State Corporation Commission
212 No. Market
Wichita, Kansas 67202

Rice County, Sec. 30 Twp. 19S Rge. 8 (W)

Location as "NE/CNW/SW" or footage from lines Ctr SW SW
Lease Owner Champlin Petroleum Company
Lease Name Smith Well No. 1
Office Address P. O. Box 308, Ellinwood, Kansas 67526
Character of Well (completed as Oil, Gas or Dry Hole) Dry Hole
Date well completed April 13 19 70
Application for plugging filed April 14 19 70
Application for plugging approved April 13 (Verbal) 19 70
Plugging commenced April 13 19 70
Plugging completed April 14 19 70
Reason for abandonment of well or producing formation _____

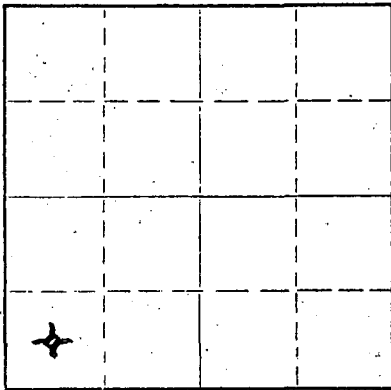

Locate well correctly on above
Section Flat

If a producing well is abandoned, date of last production _____ 19____
Was permission obtained from the Conservation Division or its agents before plugging was commenced? Yes

Name of Conservation Agent who supervised plugging of this well Gilbert Toman
Producing formation _____ Depth to top _____ Bottom _____ Total Depth of Well 3390 Feet
Show depth and thickness of all water, oil and gas formations.

OIL, GAS OR WATER RECORDS

CASING RECORD

FORMATION	CONTENT	FROM	TO	SIZE	PUT IN	PULLED OUT
				8 5/8" OD	232'	None

Describe in detail the manner in which the well was plugged, indicating where the mud fluid was placed and the method or methods used in introducing it into the hole. If cement or other plugs were used, state the character of same and depth placed, from _____ feet to _____ feet for each plug set.

Filled hole with mud to 220', pushed plug and 1/4 sack of tightly rolled hulls to 220' and dumped in 25 sacks of cement then filled hole with mud to 40' and pushed plug and 1/2 sack of hulls to 40' and filled hole to bottom of cellar using 10 sacks of cement.

Dumped 2 sacks of cement in rat hole.

RECEIVED
STATE CORPORATION COMMISSION
APR 16 1970
CONSERVATION DIVISION
Wichita, Kansas

(If additional description is necessary, use BACK of this sheet)
Name of Plugging Contractor H-30, Inc.
Address 200 N. Main, Wichita, Kansas

STATE OF Kansas, COUNTY OF Barton, ss: J. W. Meyers (employee of owner) or (owner or operator) of the above-described well, being first duly sworn on oath, says: That I have knowledge of the facts, statements, and matters herein contained and the log of the above-described well as filed and that the same are true and correct. So help me God.

(Signature) J. W. Meyers
J. W. Meyers, District Operations Manager
P. O. Box 308, Ellinwood, Kansas 67526
(Address)

SUBSCRIBED AND SWORN TO before me this 14th day of April 19 70

My commission expires 5/22/70

N. Kenneth Stivers
Notary Public.

KANSAS GEOLOGICAL SOCIETY
KANSAS WELL LOG BUREAU - KANSAS WELL SAMPLE BUREAU
KANSAS GEOLOGICAL SOCIETY BUILDING
508 EAST MURDOCK - WICHITA, KANSAS

COMPANY **Champion Petroleum Company**

SEC. **30 T. 19S R. 6W**
 LOC. **C SW SW**

FARM **Smith** NO. **1**


TOTAL DEPTH **3,390'**
 COMM. **April 7, 1970**

COMP. **April 14, 1970**

COUNTY **Rice**

KANSAS

BHPT OR TREATED
 CONTRACTOR **H-30, Inc.**
 ISSUED

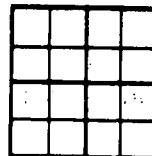

CASINO

20 10
 15 8 **5/8" 233' cemented w/200 sk cement**
 12 6
 13 5

ELEVATION **1684 OR**
1687 IF
1689 KB

PRODUCTION

FIGURES INDICATE BOTTOM OF FORMATIONS

Shale & Red Bed	232
Red Bed	595
Shale	1050
Lime & Shale	1700
Shale & Lime	2030
Lime & Shale	2360
Lime & Shale Streaks	2580
Lime & Shale	2885
Lime	2900
Lime & Shale	3332
Sand & Shale	3374
Lime	3390
Rotary Total Depth	3390

RECEIVED
 STATE CORPORATION COMMISSION
APR 20 1970
 CONSERVATION DIVISION
 Wichita, Kansas

I hereby certify the above and foregoing to be a true and correct log of the above described well as shown by the drilling reports.

H-30, INC.

Arlo B. Rower

ARLO B. ROWER

STATE OF KANSAS }
 COUNTY OF SEDGWICK } **ss:**

Subscribed and Sworn to before me a Notary Public in and for said county and state this 16th day of April, 1970.

Martha Hartpence

Martha Hartpence, Notary Public

My Commission Expires:
April 21, 1971