


Give All Information Completely  
Make Required Affidavit  
Mail or Deliver Report to:  
Conservation Division  
State Corporation Commission  
212 No. Market  
Wichita, Kansas

WELL PLUGGING RECORD

Rice County. Sec. 30 Twp. 19 Rge. 8 (E) West (W)

Location as "NE/CNW/SW" or footage from lines C SE NE  
Lease Owner Icer Addis  
Lease Name WHARTON (Washdown) Well No. #1  
Office Address Box 519, Great Bend, Kansas  
Character of Well (completed as Oil, Gas or Dry Hole) Dry Hole  
Date well completed March 12, 1970 19 70  
Application for plugging filed " " 19 70  
Application for plugging approved " " 19 70  
Plugging commenced " " " 19 70  
Plugging completed " " " 19 70  
Reason for abandonment of well or producing formation \_\_\_\_\_

NORTH

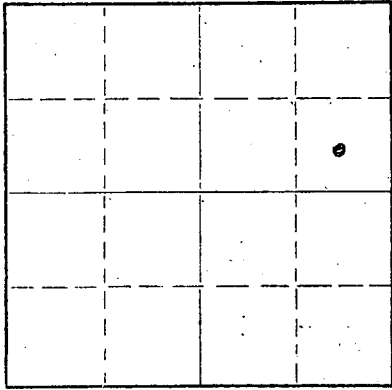

Locate well correctly on above Section Plat

If a producing well is abandoned, date of last production \_\_\_\_\_ 19 \_\_\_\_\_  
Was permission obtained from the Conservation Division or its agents before plugging was commenced? yes

Name of Conservation Agent who supervised plugging of this well Gilbert Toman  
Producing formation \_\_\_\_\_ Depth to top \_\_\_\_\_ Bottom \_\_\_\_\_ Total Depth of Well 3451 Feet  
Show depth and thickness of all water, oil and gas formations.

OIL, GAS OR WATER RECORDS

CASING RECORD

FORMATION	CONTENT	FROM	TO	SIZE	PUT IN	PULLED OUT

RECEIVED  
STATE CORPORATION COMMISSION  
MAR 13 1970  
CONSERVATION DIVISION  
Wichita, Kansas

Describe in detail the manner in which the well was plugged, indicating where the mud fluid was placed and the method or methods used in introducing it into the hole. If cement or other plugs were used, state the character of same and depth placed, from \_\_\_\_\_ feet to \_\_\_\_\_ feet for each plug set.

Hole full of heavy mud to 210'  
1/3 sk. hulls - plug - 25 sacks cement  
Hole full of heavy mud - come up to 40'  
1/2 sk. hulls - plug 10 sacks cement  
2 sacks cement in rat hole

(If additional description is necessary, use BACK of this sheet)

Name of Plugging Contractor \_\_\_\_\_  
Address \_\_\_\_\_

STATE OF Kansas, COUNTY OF Barton, ss.  
Larry Curtis (employee of owner) or ~~owner~~ of the above-described well, being first duly sworn on oath, says: That I have knowledge of the facts, statements, and matters herein contained and the log of the above-described well as filed and that the same are true and correct. So help me God.

(Signature) Larry Curtis  
Box 823 - Great Bend, Kansas 67530  
(Address)

SUBSCRIBED AND SWORN TO before me this 12th day of March, 19 70.  
Dorothy M. Hague  
Dorothy M. Hague  
Notary Public.

My commission expires April 11, 1970