

STATE OF KANSAS
STATE CORPORATION COMMISSION

Give All Information Completely
Make Required Affidavit
Mail or Deliver Report to:
Conservation Division
State Corporation Commission
211 No. Broadway
Wichita, Kansas


WELL PLUGGING RECORD

19

Rice County, Sec. 28 Twp. 23 N Rge. 8 (E) (W) X
Location as "NE/CNW/SW" or footage from lines C NW SE

Lease Owner O. A. Sutton
Lease Name Goodfellow Well No. 2
Office Address 407 Insurance Building, Wichita, Kansas
Character of Well (completed as Oil, Gas or Dry Hole) oil
Date well completed December 4 19 65
Application for plugging filed June 20 19 66
Application for plugging approved June 20 19 66
Plugging commenced June 20 19 66
Plugging completed June 25 19 66
Reason for abandonment of well or producing formation dry hole

NORTH

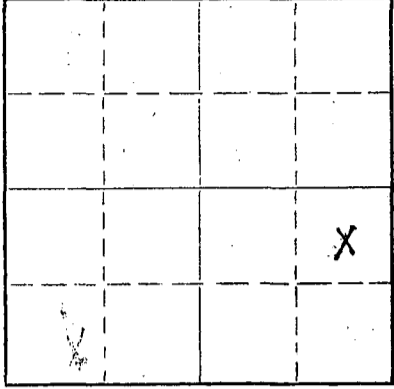

Locate well correctly on above Section Plat

If a producing well is abandoned, date of last production 19
Was permission obtained from the Conservation Division or its agents before plugging was commenced? Yes

Name of Conservation Agent who supervised plugging of this well Mr. Hugh Scott
Producing formation Kinderhook Depth to top 3350 Bottom 3361 Total Depth of Well 3391 Feet
Show depth and thickness of all water, oil and gas formations.

OIL, GAS OR WATER RECORDS

CASING RECORD

FORMATION	CONTENT	FROM	TO	SIZE	PUT IN	PULLED OUT
Kinderhook				5-1/2	3427	2430

Describe in detail the manner in which the well was plugged, indicating where the mud fluid was placed and the method or methods used in introducing it into the hole. If cement or other plugs were used, state the character of same and depth placed, from feet to feet for each plug set.

Dug out cellar. Dug deadman holes, rigged up, hauled sand, cement and water, sand back from 3368 to 3325. Dumped 5 sax cement, unpacked bradenhead, worked pipe 14". Loaded hole with water, shot @ 2414, spotted 35 bbls oil, shut well in @ 300 lb. pressure. Worked pipe loose, pulled 75 joints, total 2430 feet. Mud to 190 feet, 10 feet rock, bridge to 180 feet, dumped 3 yds ready mix cement. Tore down.

RECEIVED
STATE CORPORATION COMMISSION

JUL 28 1966

CONSERVATION DIVISION
Wichita, Kansas

(If additional description is necessary, use BACK of this sheet)
Name of Plugging Contractor Ralph Comstock Pipe Pulling
Address Stafford, Kansas

STATE OF KANSAS, COUNTY OF SEDGWICK, ss.
Jack G. Paulsen (employee of owner) or town or sponsor

well, being first duly sworn on oath, says: That I have knowledge of the facts, statements, and matters herein contained and the log of the above-described well as filed and that the same are true and correct. So help me God.

(Signature) Jack G. Paulsen
407 Insurance Building, Wichita, Kansas
(Address)

SUBSCRIBED AND SWORN TO before me this 28th day of July, 19 66

My commission expires June 17, 1969.

Patricia K. Collins
Notary Public.

