

NOTICE OF INTENTION TO DRILL

(see rules on reverse side)

Expected Spud Date..... September 2 1988
month day year

API Number 15-033-20,731-0000

OPERATOR: License #..... 5050
Name..... Hummon Corporation
Address..... 400 One Main Place
City/State/Zip..... Wichita, KS 67202
Contact Person..... Kenneth S. White
Phone..... (316) 263-8521C. SE. SW. Sec. 7 Twp. 31 S, Rg. 18
660 Ft. from South Line of Section
3300 Ft. from East Line of Section

(Note: Locate well on Section Plat on reverse side)

CONTRACTOR: License #..... 5107
Name..... H-30 Drilling, Inc.
City/State..... Wichita, KansasNearest lease or unit boundary line..... 660 feet
County..... Comanche
Lease Name..... Sherman Well #..... 1Well Drilled For: Well Class: Type Equipment:
 Oil Storage Infield Mud Rotary
 Gas Inj Pool Ext. Air Rotary
 OWWO Expl Wildcat CableGround surface elevation..... feet MSL
Domestic well within 330 feet: yes no
Municipal well within one mile: yes no

If OWWO: old well info as follows:

Operator.....
Well Name.....
Comp Date..... Old Total Depth.....Depth to bottom of fresh water..... 250
Depth to bottom of usable water..... 380 350
Surface pipe by Alternate: 1 2
Surface pipe planned to be set..... 450'
Conductor pipe required..... none
Projected Total Depth..... 5200 feet
Formation..... Mississippi

I certify that well will comply with K.S.A. 55-101, et seq., plus eventually plugging hole to KCC specifications.

Date 8/27/89 Signature of Operator or Agent Kenneth S. White Title..... Vice President

For KCC Use:

Conductor Pipe Required..... feet; Minimum Surface Pipe Required..... 370' feet per Alt. (1) X
This Authorization Expires..... 2-29-89 Approved By..... LKM 8-29-88


EFFECTIVE DATE: 8-29-88

Must be filed with the K.C.C. five (5) days prior to commencing well
This card void if drilling not started within six (6) months of date received by K.C.C.

Important procedures to follow:

1. Notify District office before setting surface casing.
2. Set surface casing by circulating cement to the top.
3. File completion forms ACO-1 with K.C.C. within 120 days of well spud date, following instructions on ACO-1, side 1, and including copies of wireline logs.
4. Notify District office 48 hours prior to old well workover or re-entry.
5. Prior to filing Intent, prepare a proposed plugging plan in case well is D & A, then obtain approval of plan when calling district office prior to setting surface pipe.
6. Submit plugging report (CP-4) to K.C.C. after plugging is completed.
7. Obtain an approved injection docket number before disposing of salt water.
8. Notify K.C.C. within 10 days when injection commences or terminates.
9. If an alternate 2 completion, cement in the production pipe from below any usable water to surface within 120 days of spud date.

A Regular Section of Land 1 Mile = 5,280 Ft.

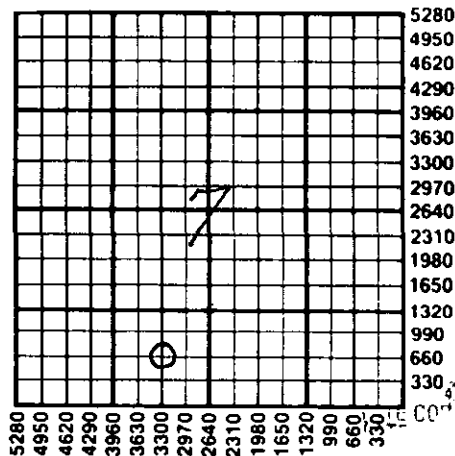

RECEIVED
STATE CORPORATION COMMISSION

AUG 29 1988
8-29-88
CONSERVATION DIVISION
Wichita, Kansas

State Corporation Commission of Kansas
Conservation Division
200 Colorado Derby Building
Wichita, Kansas 67202-1212
(316) 263-3238