

CARD MUST BE TYPED

State of Kansas
NOTICE OF INTENTION TO DRILL
(see rules on reverse side)

CARD MUST BE SIGNED

Starting Date: 12 1 85
month day year

API Number IS- 033-20,692-0000

OPERATOR: License # 5050

C. SE NE Sec 8 Twp 31 S. Rge 18 ~~XXX West~~
(location) West

Name Hummon Corporation

Address 400 One Main Place

City/State/Zip Wichita, Kansas 67202

Contact Person Wilber Berg

Phone (316) 263-8521

3300 Ft North from Southeast Corner of Section
660 Ft West from Southeast Corner of Section
(Note: Locate well on Section Plat on reverse side)

CONTRACTOR: License # 5148

Name Big-H Drilling, Inc.

City/State Wichita, Kansas 67202

Nearest lease or unit boundary line 660 feet.

County Comanche

Lease Name Thompson "A" Well# 1

Domestic well within 330 feet: yes no

Municipal well within one mile: yes no

Well Drilled For: Well Class: Type Equipment:

- Oil Swd Infield Mud Rotary
- Gas Inj Pool Ext. Air Rotary
- OWWO Expl Wildcat Cable

Depth to Bottom of fresh water 100 feet

Lowest usable water formation Cheyenne Sd

Depth to Bottom of usable water 200 feet

Surface pipe by Alternate: 1 2

Surface pipe to be set 250 feet

Conductor pipe if any required None feet

Ground surface elevation feet MSL

This Authorization Expires 5-25-86

Approved By 11-25-85

If OWWO: old well info as follows:

Operator

Well Name

Comp Date Old Total Depth

Projected Total Depth 5200 feet

Projected Formation at TD Mississippi

Expected Producing Formations Mississippi

I certify that we will comply with K.S.A. 55-101, et seq., plus eventually plugging hole to K.C.C. specifications.

Date 11/25/85 Signature of Operator or Agent

Kenneth S. White Agent

E
RCH/KSHZ

Must be filed with the K.C.C. five (5) days prior to commencing well
 This card void if drilling not started within six (6) months of date received by K.C.C.


RECEIVED
 STATE CORPORATION COMMISSION

NOV 25 1985

11-25-85
 CONSERVATION DIVISION
 Wichita, Kansas

Important procedures to follow:

A Regular Section of Land
 1 Mile = 5,280 Ft.

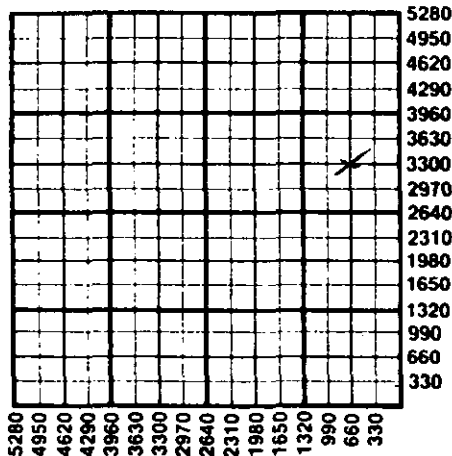

1. Notify District office before setting surface casing.
2. Set surface casing by circulating cement to the top.
3. File completion forms ACO-1 with K.C.C. within 90 days of well completion, following instructions on ACO-1, side 1, and including copies of wireline logs.
4. Notify District office 48 hours prior to old well workover or re-entry.
5. Prior to plugging, prepare a plugging plan, then obtain agreement from the appropriate district office for an approved plugging plan.
6. Submit plugging report (CP-4) to K.C.C. after plugging is completed.
7. Obtain an approved injection docket number before disposing of salt water.
8. Notify K.C.C. within 10 days when injection commences or terminates.
9. If an alternate 2 completion, cement in the production pipe from below any usable water to surface within 120 days of spud date.

State Corporation Commission of Kansas
 Conservation Division
 200 Colorado Derby Building
 Wichita, Kansas 67202
 (316) 263-3238