

CARD MUST BE TYPED

## NOTICE OF INTENTION TO DRILL

CARD MUST BE SIGNED

(see rules on reverse side)

Starting Date: ..... August 8, 1985 .....

month day year

OPERATOR: License # 5050 .....

Name ..... Hummon Corporation .....

Address ..... 400 One Main Place .....

City/State/Zip ..... Wichita, Kansas 67202 .....

Contact Person ..... Wilber Berg .....

Phone ..... (316) 263-8521 .....

CONTRACTOR: License # 5148 .....

Name ..... Big-H Drilling, Inc. ....

City/State ..... Wichita, Kansas 67202 .....

Well Drilled For: Well Class: Type Equipment:

 Oil  Swd  Infield  Mud Rotary Gas  Inj  Pool Ext.  Air Rotary OWWO  Expl  Wildcat  Cable

If OWWO: old well info as follows:

Operator .....

Well Name .....

Comp Date ..... Old Total Depth .....

Projected Total Depth ..... 5200 ..... feet

Projected Formation at TD ..... Mississippi .....

Expected Producing Formations ..... Lansing, Mississippi .....

I certify that we will comply with K.S.A. 55-101, et seq., plus eventually plugging hole to K.C.C. specifications.

Date 7-24-85 ..... Signature of Operator or Agent

Kenneth S. White  
Kenneth S. White

Agent

API Number 15- 033-20,681-0000

 EastC. NW SW. . . . Sec. 9. . Twp 31. . S, Rge. 18  West

(location)

. . . 1980. . . . Ft North from Southeast Corner of Section

. . . 4620. . . . Ft West from Southeast Corner of Section

(Note: Locate well on Section Plat on reverse side)

Nearest lease or unit boundary line ..... 660 ..... feet.

County ..... Comanche .....

Lease Name ..... Swanner ..... Well# ..... 1 .....

Domestic well within 330 feet :  yes  noMunicipal well within one mile :  yes  no

Depth to Bottom of fresh water ..... 100 ..... feet

Lowest usable water formation ..... Cheyenne Sd. ....

Depth to Bottom of usable water ..... 200 ..... feet

Surface pipe by Alternate : 1  2 

Surface pipe to be set ..... 250 ..... feet

Conductor pipe if any required ..... None ..... feet

Ground surface elevation ..... 2156 ..... feet MSL

This Authorization Expires ..... 2-2-86 .....

Approved By ..... 8-2-85 .....  
RCH for KORE

Must be filed with the K.C.C. five (5) days prior to commencing well  
This card void if drilling not started within six (6) months of date received by K.C.C.

RECEIVED  
STATE CORPORATION COMMISSION


AUG 2 1985

8-2-85

CONSERVATION DIVISION  
Wichita, Kansas

**Important procedures to follow:**

**A Regular Section of Land  
1 Mile = 5,280 Ft.**

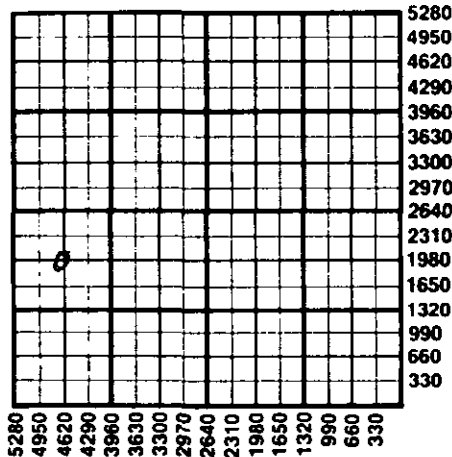

1. Notify District office before setting surface casing.
2. Set surface casing by circulating cement to the top.
3. File completion forms ACO-1 with K.C.C. within 90 days of well completion, following instructions on ACO-1, side 1, and including copies of wireline logs.
4. Notify District office 48 hours prior to old well workover or re-entry.
5. Prior to plugging, prepare a plugging plan, then obtain agreement from the appropriate district office for an approved plugging plan.
6. Submit plugging report (CP-4) to K.C.C. after plugging is completed.
7. Obtain an approved injection docket number before disposing of salt water.
8. Notify K.C.C. within 10 days when injection commences or terminates.
9. If an alternate 2 completion, cement in the production pipe from below any usable water to surface within 120 days of spud date.

State Corporation Commission of Kansas  
Conservation Division  
200 Colorado Derby Building  
Wichita, Kansas 67202  
(316) 263-3238