

NOTICE OF INTENTION TO DRILL

(see rules on reverse side)



Expected Spud Date... 8 27 88 month day year

API Number 15-007-22,203-0000

OPERATOR: License # 09408
Name Trans Pacific Oil Corporation
Address 410 One Main
City/State/Zip Wichita, Ks. 67202
Contact Person Alan D. Banta
Phone 316-262-3596

NE 3630 SW NE. Sec. 5 Twp. 30. S. Rg. 13. X West
1650 Ft. from South Line of Section
1650 Ft. from East Line of Section

(Note: Locate well on Section Plat on reverse side)

CONTRACTOR: License # 05841
Name Trans Pac Drilling, Inc.
City/State Wichita Ks. 67202

Nearest lease or unit boundary line 330 feet
County Barber
Lease Name Lambert "A" Well # 1

Well Drilled For: Well Class: Type Equipment:
X Oil Storage Infield x Mud Rotary
Gas Inj Pool Ext. Air Rotary
OWWO X Expl Wildcat Cable

Ground surface elevation feet MSL
Domestic well within 330 feet: yes no
Municipal well within one mile: yes no
Depth to bottom of fresh water 180
Depth to bottom of usable water 220
Surface pipe by Alternate: 1 X 2
Surface pipe planned to be set 240
Conductor pipe required
Projected Total Depth 4775 feet
Formation Arbuckle

If OWWO: old well info as follows:

Operator
Well Name
Comp Date Old Total Depth

I certify that well will comply with K.S.A. 55-101, et seq., plus eventually plugging hole to KCC specifications.

Date 8/26/88 Signature of Operator or Agent [Signature] Title Office Manager

For KCC Use:

Conductor Pipe Required feet; Minimum Surface Pipe Required 240' feet per Alt. (1) X
This Authorization Expires 2-26-89 Approved By LKM 8-26-88


EFFECTIVE DATE: 8-31-88

Must be filed with the K.C.C. five (5) days prior to commencing well  
This card void if drilling not started within six (6) months of date received by K.C.C.

### Important procedures to follow:

1. Notify District office before setting surface casing.
2. Set surface casing by circulating cement to the top.
3. File completion forms ACO-1 with K.C.C. within 120 days of well spud date, following instructions on ACO-1, side 1, and including copies of wireline logs.
4. Notify District office 48 hours prior to old well workover or re-entry.
5. Prior to filing Intent, prepare a proposed plugging plan in case well is D & A, then obtain approval of plan when calling district office prior to setting surface pipe.
6. Submit plugging report (CP-4) to K.C.C. after plugging is completed.
7. Obtain an approved injection docket number before disposing of salt water.
8. Notify K.C.C. within 10 days when injection commences or terminates.
9. If you alternate 2 completion, cement in the production pipe from below any usable water to surface within 120 days of spud date.

### A Regular Section of Land 1 Mile = 5,280 Ft.

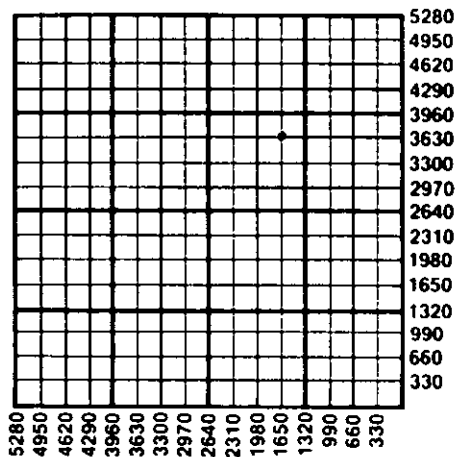

FILED  
JG 26 1988  
8-26-88  
WICHITA, KANSAS

State Corporation Commission of Kansas  
Conservation Division  
200 Colorado Derby Building  
Wichita, Kansas 67202-1212  
(316) 263-3238