

NOTICE OF INTENTION TO DRILL

(see rules on reverse side)

Starting Date 2 15 86
 month day year

API Number 15— 007-22,117-0000

OPERATOR: License # 5399
 Name American Energies Corporation
 Address 575 Fourth Financial Center
 City/State/Zip Wichita, Kansas
 Contact Person Hal Brown
 Phone 316/263-5785

N/2 N/2 SW Sec. 5 Twp. 30 S, Rg. 13 East
 West
 2310 Ft. from South Line of Section
 3960 Ft. from East Line of Section

(Note: Locate well on Section Plat on reverse side)

CONTRACTOR: License # 5418
 Name Allen Drilling Co.
 City/State Great Bend, Kansas

Nearest lease or unit boundary line 330 feet
 County Barber
 Lease Name BELL "C" Well # 1

Well Drilled For: Well Class: Type Equipment:
 Oil SWD Infield Mud Rotary
 Gas Inj Pool Ext. Air Rotary
 OWWO Expl Wildcat Cable

Ground surface elevation N/A feet MSL
 Domestic well within 330 feet: yes no
 Municipal well within one mile: yes no
 Surface pipe by Alternate: 1 2
 Depth to bottom of fresh water 2175
 Depth to bottom of usable water 250'
 Surface pipe planned to be set 300'
 Projected Total Depth 4800 feet
 Formation Arbuckle

If OWWO: old well info as follows:

Operator
 Well Name
 Comp Date Old Total Depth

I certify that well will comply with K.S.A. 55-101, et seq., plus eventually plugging hole to KCC specifications.

RW/10/85

_____ cementing will be done immediately upon setting production casing.

Date 12/18/85 Signature of Operator or Agent *Allen D. [Signature]* Title Vice-President

For KCC Use:


Conductor Pipe Required feet; Minimum Surface Pipe Required feet per Alt. 2
 This Authorization Expires 6-18-86 Approved By 12-18-85 *[Signature]*

Must be filed with the K.C.C. five (5) days prior to commencing well
This card void if drilling not started within six (6) months of date received by K.C.C.

Important procedures to follow:

1. Notify District office before setting surface casing.
2. Set surface casing by circulating cement to the top.
3. File completion forms ACO-1 with K.C.C. within 90 days of well completion, following instructions on ACO-1, side 1, and including copies of wireline logs.
4. Notify District office 48 hours prior to old well workover or re-entry.
5. Prior to filing Intent, prepare a proposed plugging plan in case well is D & A, then obtain approval of plan when calling district office prior to setting surface pipe.
6. Submit plugging report (CP-4) to K.C.C. after plugging is completed.
7. Obtain an approved injection docket number before disposing of salt water.
8. Notify K.C.C. within 10 days when injection commences or terminates.
9. If an alternate 2 completion, cement in the production pipe from below any usable water to surface within 120 days of spud date.

A Regular Section of Land 1 Mile = 5,280 Ft.

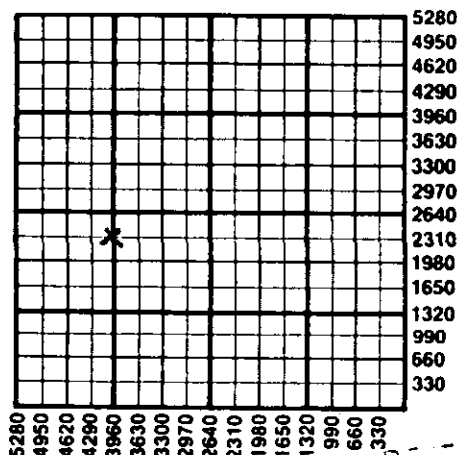

RECEIVED
STATE CORPORATION COMMISSION

DEC 18 1985
12-18-85
CONSERVATION DIVISION
Wichita, Kansas

State Corporation Commission of Kansas
Conservation Division
200 Colorado Derby Building
Wichita, Kansas 67202
(316) 263-3238