

STATE CORPORATION COMMISSION

CONSERVATION DIVISION AGEN'T REPORT

J. Lewis Breck  
Administrator  
245 North Water  
Wichita, Ks. 67202

API Number 15 -033-20258-0000 (of this well)

Operator's Full Name Pickrell Drlg., Co.

Complete Address Litwin Bldg., Suite 205, Wichita, Ks. 67202

Lease Name Delaney "B" Well No. 1

Location 200' SE SE NW Sec 36 Twp. 31s Rge. 18 (E) (W) X

County Comanche Total Depth 5226

Abandoned Oil Well X Gas Well      Input Well      SWD Well      D&A     

Other well as hereafter indicated     

Plugging Contractor Clarke Corp.

Address 107 W. Fowler, Medicine Lodge, Ks. 67104 License No. 583

Operation Completed: Hour 3:30 Day Thu. 12 Month 6 Year 1980

The Above well was plugged as follows:

606' 8 5/8" casing. 4 1/2" casing set at 5224' w/150 sax cement. Plug  
back to 5145'-Preforated at 5125'-Sand back to 5100' top sand w/4  
sax mixed cement w/dump bailer. Pull 3580' casing-Bridge at 540'-  
Fill 8 5/8" casing w/ 8 yard grout to top of casing by Hildinger  
Ready Mix.

RECEIVED  
STATE CORPORATION COMMISSION

JUN 16 1980  
6-16-80

CONSERVATION DIVISION

I hereby certify that the above well was plugged as herein stated.

Signed: [Signature]  
Well Plugging Supervisor

INVOICED

DATE 6-19-80


INV. NO. 2384w

DATE 5-19-80 WELL NO. 1 LEASE DeLaney B FIELD Wilmore

ELEV.:

2149 KB

2144 GL

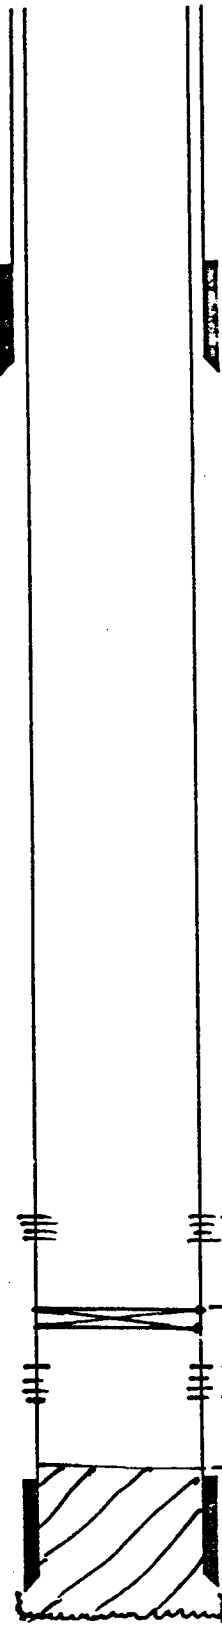

— 8 5/8" @ 606 w/400 Sx

≡ ≡ ≡ } 5125-5135 (Miss. Perfs.)

— 5145 (CIBP)

≡ ≡ ≡ } 5152-5157 (Miss. Perfs.)

— 5185 PBTD (Loggers)

— 5224 Base 4 1/2" 10.5# K-SS w/150 Sx Common

— 5226 LTD

RECEIVED  
STATE OF KANSAS COMMISSION  
MAY 21 1980  
5-21-80  
CONSERVATION DIVISION  
Topeka, Kansas

15-033-20258-0000  
ROTARY DRILLING LOG

COMPANY: PICKRELL DRILLING COMPANY  
 205 LITWIN BLDG.  
 WICHITA, KS. 67202  
 LOCATION: DELANEY "B" #1  
 SE NW Sec. 36-31S-18W  
 Comanche Co., Ks.  
 CONTRACTOR: PICKRELL DRILLING COMPANY  
 Wichita, Kansas

Rotary Drilling Commenced 7-15-78  
 Rotary Drilling Completed 7-28-78

CASING RECORD:

Surf. casing 8 5/8" set at 606' with 400sx.  
 Prod. casing 4 1/2" set at 5224' with 150sx.

LOG

(Figures indicate bottom of formation — measurements from top of rotary bushing.)

Sand	285
Red Beds & Shale	600
Shale	654
Shale	780
Shale	1279
Shale & Lime	1752
Shale & Lime	2080
Shale & Sand	2495
Lime & Shale	2587
Lime & Shale	2735
Lime & Shale	2915
Lime & Shale	3047
Lime & Shale	3223
Lime & Shale	3410
Lime & Shale	3550
Lime	3697
Lime & Shale	3812
Lime & Shale	3015
Lime	3984
Shale	4055
Lime & Shale	4093
Lime & Shale	4270
Lime	4415
Lime	4555
Lime & Shale	4688
Lime & Shale	4793
Lime	4897
Shale & Lime	4989
Lime	5070
Lime	5146
Lime	5160
Lime	5177
Lime	5217
Lime	5225

RECEIVED  
 MAY 21 1980  
 5-21-80  
 INVESTIGATION DIVISION  
 Wichita, Kansas

The undersigned, C. W. Sebitts, Attorney-in-Fact for PICKRELL DRILLING COMPANY, hereby certifies in behalf of said Company, that the above is a true and correct log of the formation encountered in drilling the above well as reflected by the Daily Drilling Reports.


PICKRELL DRILLING COMPANY  
 By [Signature]  
 Attorney-in-Fact  
 C. W. Sebitts

STATE OF KANSAS }  
 COUNTY OF SEDGWICK } ss.:

On this 16 day of November, 19 78, before me the undersigned, a Notary Public, in and for the County and State aforesaid, personally appeared C. W. Sebitts, to me known to be the identical person who subscribed the name of PICKRELL DRILLING COMPANY to the foregoing instrument as its Attorney-in-Fact and acknowledged to me that he executed the same as his free and voluntary act and deed, and as the free and voluntary act and deed of such company, for the uses and purposes therein set forth.

Given under my hand and seal of office the day and year last above written.

My commission expires: 2-18-80

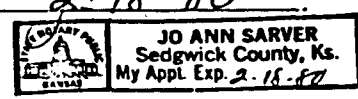

[Signature]  
 Notary Public  
 Jo Ann Sarver