


STATE OF KANSAS  
STATE CORPORATION COMMISSION

Form CP-4

Give All Information Completely  
Make Required Affidavit  
Mail or Deliver Report to:  
Conservation Division  
State Corporation Commission  
211 No. Broadway P.O. Box 17027  
Wichita, Kansas 67217  
NORTH

WELL PLUGGING RECORD

Comanche County. Sec. 27 Twp. 32S Rge. (E) 16 (W)  
Location as "NE/CNW%SW%" or footage from lines c SW SW  
Lease Owner H. B. Mabee  
Lease Name Wait Ranch Well No. 2  
Office Address P. O. Box 94718, Oklahoma City, Okla. 73109  
Character of Well (completed as Oil, Gas or Dry Hole) Dry Hole  
Date well completed April 1 19 73  
Application for plugging filed April 1 19 73  
Application for plugging approved April 1 19 73  
Plugging commenced April 1 19 73  
Plugging completed April 1 19 73  
Reason for abandonment of well or producing formation Dry Hole

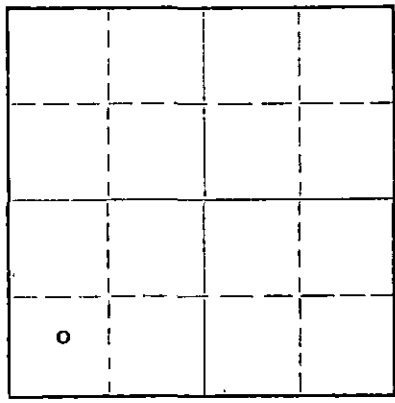

Locate well correctly on above Section Plat

If a producing well is abandoned, date of last production 19  
Was permission obtained from the Conservation Division or its agents before plugging was commenced? Yes

Name of Conservation Agent who supervised plugging of this well G. R. Biberstein, Attica, Kansas 67009  
Producing formation Depth to top Bottom Total Depth of Well 5095 Feet  
Show depth and thickness of all water, oil and gas formations.

OIL, GAS OR WATER RECORDS

CASING RECORD

FORMATION	CONTENT	FROM	TO	SIZE	PUT IN	PULLED OUT
		0	407'	8 5/8"	407'	None

Describe in detail the manner in which the well was plugged, indicating where the mud fluid was placed and the method or methods used in introducing it into the hole. If cement or other plugs were used, state the character of same and depth placed, from feet to feet for each plug set.

Plug: 400' w/40 sacks cement  
40' w/15 sacks cement

RECEIVED  
STATE CORPORATION COMMISSION  
APR 9 1973  
CONSERVATION DIVISION  
Wichita, Kansas

(If additional description is necessary, use BACK of this sheet)

Name of Plugging Contractor Hellar Drilling Company, Inc.  
Address 339 Union Center Bldg., Wichita, Kansas 67202

DRILLER'S LOG

COMPANY: H. B. Mabee, P. O. Box 94718, Oklahoma City, Okla. 73109  
CONTRACTOR: Hellar Drilling Company, Inc., Wichita, Kansas 67202  
LEASE: #2 Wait Ranch  
LOCATION: c SW SW 27-32S-16W, Comanche County, Kansas  
COMMENCED: March 19, 1973  
COMPLETED: April 1, 1973  
CASING: Set 8 5/8" Surface Casing @ 407' w/350 sacks cement

---

0-410	Red Bed & Sand
410-715	Shale
715-855	Sand & Shale
855-1100	Shale & Shells
1100-1645	Shale & Anhydrite Streaks
1645-2229	Salt Section
2229-2395	Lime
2395-2747	Lime & Shale (Ft. Riley)
2747-2920	Lime & Shale
2920-3294	Lime w/Shale Streaks
3294-3424	Lime & Shale
3424-3605	Lime & Shale (Topeka)
3605-3743	Lime & Shale
3743-3860	Lime
3860-3994	Lime w/Shale Streaks
3994-4040	Lime
4040-4061	Douglas Section
4061-4165	Lime & Shale
4165-4197	Lime
4197-4315	Douglas Shale
4315-4430	Lime
4430-4550	Lime (L.K.C.)
4550-4638	Lime
4638-4719	Lime & Shale Streaks
4719-4777	Lime & Shale
4777-5040	Lime
5040-5095	Miss.
5095	Rotary Total Depth

D & A

RECEIVED  
STATE CORPORATION COMMISSION  
APR 9 1973  
CONSERVATION DIVISION  
Wichita, Kansas

---

STATE OF KANSAS        )  
                          ) SS  
COUNTY OF SEDGWICK )

I, D. L. Hellar, do hereby certify that the above and foregoing is a true and