

STATE OF KANSAS  
STATE CORPORATION COMMISSION


WELL PLUGGING RECORD

Give All Information Completely  
Make Required Affidavit  
Mail or Deliver Report to:  
Conservation Division  
State Corporation Commission  
800 Bitting Building  
Wichita, Kansas

Comanche County. Sec. 30 Twp. 32 Rge. NE (E) 16 (W)

Location as "NE/CNW%SW%" or footage from lines \_\_\_\_\_  
Lease Owner Barbara Oil Company  
Lease Name Eden Well No. 1  
Office Address 322 Central Building, Wichita 2, Kansas  
Character of Well (completed as Oil, Gas or Dry Hole) D&A  
Date well completed December 29, 19 54  
Application for plugging filed December 29, 19 54  
Application for plugging approved Verbally December 29, 19 54  
Plugging commenced December 29, 19 54  
Plugging completed 7 A.M. December 30, 19 54  
Reason for abandonment of well or producing formation D&A

NORTH

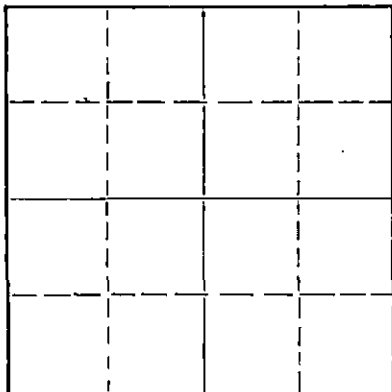

Locate well correctly on above  
Section Plat

If a producing well is abandoned, date of last production \_\_\_\_\_ 19\_\_\_\_  
Was permission obtained from the Conservation Division or its agents before plugging was commenced? Yes verbally

Name of Conservation Agent who supervised plugging of this well M.A. Rives  
Producing formation \_\_\_\_\_ Depth to top \_\_\_\_\_ Bottom \_\_\_\_\_ Total Depth of Well 5770 Feet  
Show depth and thickness of all water, oil and gas formations.

OIL, GAS OR WATER RECORDS

CASING RECORD

FORMATION	CONTENT	FROM	TO	SIZE	PUT IN	PULLED OUT
				<u>10-3/4"</u>	<u>290'</u>	

Describe in detail the manner in which the well was plugged, indicating where the mud fluid was placed and the method or methods used in introducing it into the hole. If cement or other plugs were used, state the character of same and depth placed, from \_\_\_\_\_ feet to \_\_\_\_\_ feet for each plug set.  
Filled with heavy mud from 5770' to 290', set Halliburton bridge plug, ran 25 sacks of cement on top of plug which plugged hole up to 230', heavy mud from 230' to 35', set bridge plug at 35' and filled with cement to bottom of cellar.

(If additional description is necessary, use BACK of this sheet)

Name of Plugging Contractor H.C. Patton Company  
Address Orpheum Building, Wichita 2, Kansas

STATE OF Kansas, COUNTY OF Sedgwick, ss. L.W. Davidson (employee of owner) or (owner/operator) of the above-described

Barbara Oil Company  
 Eden Well #1  
 Total Depth  
 Comm.  
 Comp.  
 Contractor R. C. Patton Co.,

Location Center of NE/4, NE/4, Sec. 30-  
 T52S-R16W, Comanche County, Kansas.

5770'  
 11/21/54 10 3/4" Casing at 290 Feet  
 12/30/54 Cemented with 250 Sacks Cement

Surface Clay	25
Sand & Sandy Loam	90
Red Bed & Clay	215
Red Shale	265
Gyp & Red Shale	275
Shale	335
Red Bed & Shells	960
Red Shale & Anhy. Shells	1155
Shale & Shells	1925
Anhydrite & Shale	2215
Lime & Shale	4048
Lime Shale & Sand	4100
Sand & Shale	5150
Sand Lime	4192
Lime & Shale	4300
Sand & Sandy Lime	4342
Lime & Shale	4401
Sandy Lime & Shale	4454
Lime & Shale	4560
Lime	4877
Lime & Shale	5085
Cherty Lime	5103
Cherty Lime & Shale	5203
Lime & Shale	5247
Lime	5437
Lime & Shale	5463
Lime	5465
Lime & Shale	5491
Lime	5644
Sandy Shale & Sand	5678
Sandy Shale	5703
Shale	5726
Sand & sandy Shale	5740
Lime & Shale	5745
Lime	5770
Total Depth	5770

STATE OF Kansas COUNTY OF Edgewood ss,

I, the undersigned, being duly sworn, on oath state that the above statement and log is a true and correct record and log of the the well drilled at the location above described.

R. C. PATTON CO.,

By Robert W. Patton