

STATE OF KANSAS
STATE CORPORATION COMMISSION
CONSERVATION DIVISION
P. O. BOX 17027
WICHITA, KANSAS 67217

WELL PLUGGING RECORD

Comanche County. Sec. 31 Twp. 32S Rge. 16W (E) (W)

Location as "NE/CNW/SW" or footage from lines Center SE 1/4 NE 1/4

Lease Owner Clarke Corporation

Lease Name Eden Well No. 1

Office Address 107 W. Fowler, Medicine Lodge, Kan. 67104

Character of Well (completed as Oil, Gas or Dry Hole) dry

Date well completed February 19 74

Application for plugging filed 19

Application for plugging approved 19

Plugging commenced 7-28- 19 76


Plugging completed 8-5 19 76

Reason for abandonment of well or producing formation

Not productive

If a producing well is abandoned, date of last production No 19

Was permission obtained from the Conservation Division or its agents before plugging was commenced? Yes

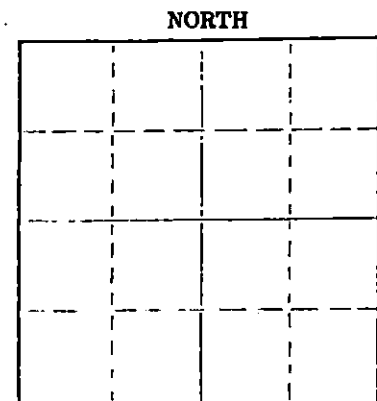

Locate well correctly on above Section Plat

Name of Conservation Agent who supervised plugging of this well Russell Biberstein

Producing formation _____ Depth to top _____ Bottom _____ Total Depth of Well 4900'

Show depth and thickness of all water, oil and gas formations.

OIL, GAS OR WATER RECORDS

CASING RECORD

FORMATION	CONTENT	FROM	TO	SIZE	PUT IN	PULLED OUT
				8 5/8	240	None
				2 7/8	4900	3067

Describe in detail the manner in which the well was plugged, indicating where the mud fluid was placed and the method or methods used in introducing it into the hole. If cement or other plugs were used, state the character of same and depth placed, from _____ feet to _____ feet for each plug set.

Pumped in sand from 4900' to 4700'

Pumped in 4 sacks cement from 4700' to 4600'

Shot off pipe at 3067'

Pulled and layed down

Wooden bridge at 220' Rock from 220' to 210'

25 sacks cement from 210' to 135'

Mud to 40' Rock from 40' to 30' then 10 sacks cement to surface

(If additional description is necessary, use BACK of this sheet)

Name of Plugging Contractor Clarke Corporation

Address Box 187, Medicine Lodge, Kan. 67104

STATE OF Kansas COUNTY OF Barber ss.

Elmo R. Margenatern (employee of owner) or (owner or operator) of the above-described

well, being first duly sworn on oath, says: That I have knowledge of the facts, statements, and matters herein contained and the log of the above-described well as filed and that the same are true and correct. So help me God.

(Signature) Elmo R. Margenatern
Medicine Lodge, Kansas 67104
(Address)

Subscribed AND SWORN TO before me this 10th day of August 1976

RECEIVED
STATE CORPORATION COMMISSION
8-12-76
AUG 12 1976

CONSERVATION DIVISION
Wichita, Kansas