


STATE OF KANSAS  
STATE CORPORATION COMMISSION  
CONSERVATION DIVISION  
P. O. BOX 17027  
WICHITA, KANSAS 67217

FORM CP-4

WELL PLUGGING RECORD

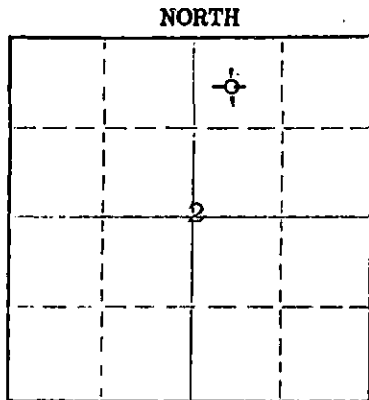

Locate well correctly on above Section Plot

Comanche County, Sec. 2 Twp 31S Rge 18W ~~23E~~ (W)  
Location as "NE/CNW/SW" or footage from lines C NW NE  
Lease Owner Banks Oil Company  
Lease Name Herrington Well No. 1  
Office Address 360 Sutton Place, Wichita, Kansas 67202  
Character of Well (completed as Oil, Gas or Dry Hole) Dry Hole  
Date well completed December 20, 1975  
Application for plugging filed December 20, 1975  
Application for plugging approved December 20, 1975  
Plugging commenced December 20, 1975  
Plugging completed December 20, 1975  
Reason for abandonment of well or producing formation Dry Hole

If a producing well is abandoned, date of last production 19  
Was permission obtained from the Conservation Division or its agents before plugging was commenced? Yes

Name of Conservation Agent who supervised plugging of this well \_\_\_\_\_  
Producing formation \_\_\_\_\_ Depth to top \_\_\_\_\_ Bottom \_\_\_\_\_ Total Depth of Well 5082 Feet  
Show depth and thickness of all water, oil and gas formations.

OIL, GAS OR WATER RECORDS

CASING RECORD

FORMATION	CONTENT	FROM	TO	SIZE	PUT IN	PULLED OUT
		0'	452'	8-5/8"	452'	None

Describe in detail the manner in which the well was plugged, indicating where the mud fluid was placed and the method or methods used in introducing it into the hole. If cement or other plugs were used, state the character of same and depth placed, from \_\_\_\_\_ feet to \_\_\_\_\_ feet for each plug set.

Spotted with 35 sacks cement at 350',  
bridge plug and 15 sacks cement at 40',  
2 sacks cement in rat hole.

12-23-75

(If additional description is necessary, use BACK of this sheet)  
Name of Plugging Contractor Cementing Company  
Address \_\_\_\_\_

STATE OF KANSAS COUNTY OF SEDGWICK ss.  
John D. Knightley, Agent (employee of owner) or (owner or operator) of the above-described

well, being first duly sworn on oath, says: That I have knowledge of the facts, statements, and matters herein contained and the log of the above-described well as filed and that the same are true and correct. So help me God.

(Signature) [Signature]  
301 S. Broadway, Wichita, Kansas  
(Address)

Banks Oil Company - Herrington #1  
 C NW NE Sec. 2-31S-18W  
 Comanche County, Kansas

Contractor: D. R. Lauck Oil Company, Inc.  
 301 S. Broadway  
 Wichita, Kansas 67202

Commenced: December 7, 1975  
 Completed: December 20, 1975

Drillers Log

Clay & Shale	75
Sand	250
Red Bed	330
Sand	360
Shale	850
Shale & Shells	1725
Shale	2025
Shale & Lime Streaks	2200
Shale & Lime	2405
Lime & Shale	2860
Shale & Lime	3340
Shale	3505
Shale & Lime	3830
Lime & Shale	4090
Lime	5082 RTD

RECEIVED  
 STATE GEOLOGICAL SURVEY  
 DEC 23 1975  
 12-23-75  
 COMMANCHE COUNTY  
 WICHITA, KANSAS