

STATE OF KANSAS
STATE CORPORATION COMMISSION
CONSERVATION DIVISION
P. O. BOX 17027
WICHITA, KANSAS 67217

FORM CP-4

WELL PLUGGING RECORD

Comanche County. Sec. 2 Twp. 31S Rge. 18W (E)X (W)

Location as "NE/CNW&SW" or footage from lines C NW SW

Lease Owner Lee Banks

Lease Name Toothaker Well No. 1

Office Address 360 Sutton Place, Wichita, Kansas 67202

Character of Well (completed as Oil, Gas or Dry Hole) Dry Hole

Date well completed February 27, 1977

Application for plugging filed February 27, 1977

Application for plugging approved February 27, 1977


Plugging commenced February 27, 1977

Plugging completed February 27, 1977

Reason for abandonment of well or producing formation Dry Hole

If a producing well is abandoned, date of last production 19

Was permission obtained from the Conservation Division or its agents before plugging was commenced? Yes

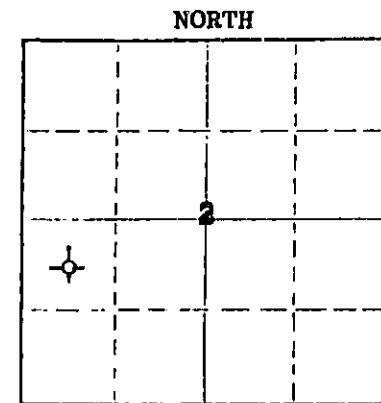

Locate well correctly on above Section Plat

Name of Conservation Agent who supervised plugging of this well

Producing formation Depth to top Bottom Total Depth of Well 5095 Feet

Show depth and thickness of all water, oil and gas formations.

OIL, GAS OR WATER RECORDS

CASING RECORD

FORMATION	CONTENT	FROM	TO	SIZE	PUT IN	FULLED OUT
		0'	369'	12-3/4"	369'	None

Describe in detail the manner in which the well was plugged, indicating where the mud fluid was placed and the method or methods used in introducing it into the hole. If cement or other plugs were used, state the character of same and depth placed, from feet to feet for each plug set.

Spotted with 35 sacks cement at 340',
plug; filled hole to 40' with plug,
1/2 sack hulls, 20 sacks cement;
5 sacks cement in rat hole.

RECEIVED
STATE CORPORATION COMMISSION

MAR 03 1977

3-3-77
CONSERVATION DIVISION
WICHITA, KANSAS

(If additional description is necessary, use BACK of this sheet)

Name of Plugging Contractor Halliburton Cementing Co.

Address Pratt, Kansas 67124

STATE OF KANSAS COUNTY OF SEDGWICK ss.

John D. Knightley, agent, (employee of owner) or (owner or operator) of the above-described well, being first duly sworn on oath, says: That I have knowledge of the facts, statements, and matters herein contained and the log of the above-described well as filed and that the same are true and correct. So help me God.

(Signature) [Signature]

301 S. Broadway, Wichita, Kansas
(Address)

Subscribed and Sworn to before me this 1st day of March 19 77

Lee Banks

-

Toothaker #1

C NW SW Sec.2-31S-18W

Comanche County, Kansas

Contractor: D. R. Lauck Oil Company, Inc.
 301 S. Broadway
 Wichita, Kansas 67202

Commenced: February 13, 1977

Completed: February 27, 1977

Drillers Log

Clay	60
Sand	116
Shale	166
Sand	227
Red Bed	330
Sand	372
Red Bed	1000
Shale & Shells	1725
Shale	2200
Lime & Shale	2860
Shale & Lime	3760
Shale	3830
Lime	3905
Lime & Shale	4655
Lime	5010
Miss.	5025
Lime	5047
Miss.	5095 RTD

RECEIVED
 STATE CORPORATION COMMISSION

MAR 03 1977
 3-3-77
 CONSERVATION DIVISION
 Wichita, Kansas