


STATE OF KANSAS  
STATE CORPORATION COMMISSION

WELL PLUGGING RECORD

Give All Information Completely  
Make Required Affidavit  
Mail or Deliver Report to  
Conservation Division  
State Corporation Comm.  
245 North Water  
Wichita, KS 67202

Comanche County, Sec. 12 Twp. 32 Rge. 16W E/W  
Location as "NE/CNW<sup>1</sup>/SW<sup>1</sup>" or footage from lines  
NE NE SE

Lease Owner Messman Reinhart Corporation  
Lease Name Perry #1 Well No. \_\_\_\_\_  
Office Address Wichita, Kansas 67202  
Character of Well (Completed as Oil, Gas or Dry Hole) \_\_\_\_\_

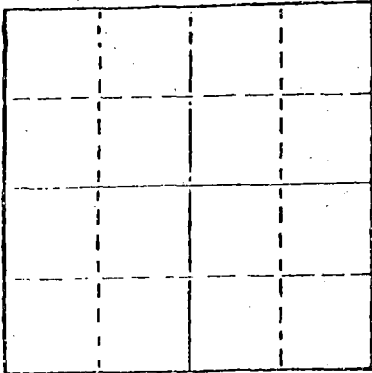

Locate well correctly on above  
Section Plat

Date Well completed \_\_\_\_\_ 19\_\_\_\_  
Application for plugging filed \_\_\_\_\_ 19\_\_\_\_  
Application for plugging approved \_\_\_\_\_ 19\_\_\_\_  
Plugging commenced 7/19/77 \_\_\_\_\_ 19\_\_\_\_  
Plugging completed 7/26/77 \_\_\_\_\_ 19\_\_\_\_  
Reason for abandonment of well or producing formation  
depleted.

If a producing well is abandoned, date of last production  
\_\_\_\_\_ 19\_\_\_\_

Was permission obtained from the Conservation Division or  
its agents before plugging was commenced? yes

Name of Conservation Agent who supervised plugging of this well Metz  
Producing formation \_\_\_\_\_ Depth to top \_\_\_\_\_ Bottom \_\_\_\_\_ Total Depth of Well 4919  
Show depth and thickness of all water, oil and gas formations.

OIL, GAS OR WATER RECORDS

CASING RECORD

FORMATION	CONTENT	FROM	TO	SIZE	PUT IN	PULLED OUT
				10-3/4	210	none
				5 1/2"	4875	3805'

Describe in detail the manner in which the well was plugged, indicating where the mud fluid was placed and the method or methods used in introducing it into the hold. If cement or other plugs were used, state the character of same and depth placed, from \_\_\_\_\_ feet to \_\_\_\_\_ feet for each plug set.

Squeezed bottom hole with 50 sacks common cement, top of cement 4410'. Cut off braden head and welded 10-3/4 collar on. Installed control head, checked hole and found cement at 4825', sanded to 4750' and ran 5 sacks cement. Shot pipe at 4200, 4015', 3795', pulled 116 joints. Mudded hole to 285', 15' rock bridge to 270', ran 6 1/2 yards ready mix.

PLUGGING COMPLETE.

RECEIVED  
STATE CORPORATION COMMISSION

AUG 08 1977

8-8-77  
CONSERVATION DIVISION

(If additional description is necessary, use BACK of \_\_\_\_\_ sheet)  
Name of Plugging Contractor KELSO CASING PULLING  
CHASE, KANSAS

STATE OF KANSAS COUNTY OF RICE, ss.  
R. DARRELL KELSO (employee of owner) or (owner or operator)  
of the above-described well, being first duly sworn on oath, says: That I have knowledge of the facts, statements, and matters herein contained and the log of the above-described well as filed and that the same are true and correct. So help me God.

(Signature) R. Darrell Kelso  
CHASE, KANSAS  
(Address)

SUBSCRIBED AND SWORN TO before me this 4th day of August, 19 77

My commission expires \_\_\_\_\_



Margaret Melcher  
Notary Public.

# WELL LOG

02

COMPANY MESSMAN-RINEHART OIL COMPANY

SEC. 12 T.32S R. 16W

FARM PERRY NO. 1


LOC. ~~COMANCHE CO., KANSAS~~  
NE, NE, SE

TOTAL DEPTH 4919'

COUNTY COMANCHE CO., KANSAS

COMM. June 10, 1958 COMP. June 27, 1958

CONTRACTOR GARVEY DRILLING COMPANY

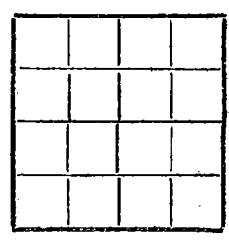

CASING 10 3/4" @ 276' W/200 sax.  
5 1/2" @ 4919' W/75 sax.

ELEVATION 1951' DF

PRODUCTION

FIGURES INDICATE BOTTOM OF FORMATIONS

285	Red bed & shale
465	Shale & red bed
950	Red bed & shells
1120	Salt & shale
1825	Shale & shells
2115	Shale & lime
2135	Anhydrite
2150	Shale
2280	Broken lime
2490	Lime
2676	Shale & lime
2758	Lime & shale
2982	Shale & lime
3155	Shale
3576	Shale & lime
3818	Lime & shale
4192	Lime
4249	Lime & shale
4779	Lime
4919	Lime & chert
4919	T. D.

RECEIVED  
STATE CORPORATION COMMISSION

AUG 11 1977

CONSERVATION DIVISION  
Wichita, Kansas

State of KANSAS }  
County of BARTON } ss:

I, VERNE A. MORRIS of GARVEY DRILLING COMPANY

upon oath state that the above and foregoing is a true and correct copy of the log of the #1 PERRY well

Subscribed and sworn to before me this 9th day of July 1958

My Commission Expires: November 12, 1958

Verne A. Morris  
Notary Public