

STATE OF KANSAS
STATE CORPORATION COMMISSION

Give All Information Completely
Make Required Affidavit
Mail or Deliver Report to:
Conservation Division
State Corporation Commission
211 No. Broadway
Wichita, Kansas

WELL PLUGGING RECORD

Comanche County, Sec. 2 Twp 32S Rge. 18W (E) (W)

Location as "NE/CNW/SW" or footage from lines C-SE NW

Lease Owner Livingston Oil Company

Lease Name Victory Life Well No. 1

Office Address Box 1797, Tulsa 1, Oklahoma

Character of Well (completed as Oil, Gas or Dry Hole) Gas & Oil

Date well completed October 1, 1964

Application for plugging filed October 20, 1964

Application for plugging approved October 21, 1964


Plugging commenced October 21, 1964 19

Plugging completed October 26, 1964 19

Reason for abandonment of well or producing formation Non-commercial

If a producing well is abandoned, date of last production none 19

Was permission obtained from the Conservation Division or its agents before plugging was commenced? yes

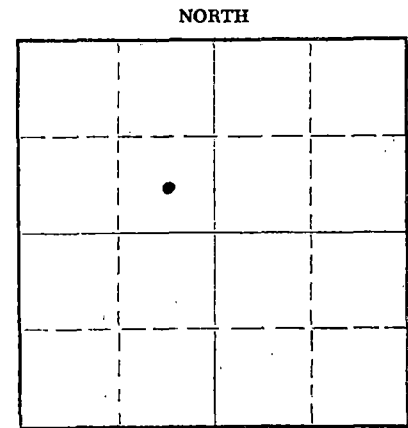

Locate well correctly on above Section Plat

Name of Conservation Agent who supervised plugging of this well Archie V. Elving Pratt, Kansas

Producing formation Mississippian Depth to top 5,158 Bottom 5,200 Total Depth of Well 6,117 Feet

Show depth and thickness of all water, oil and gas formations.

OIL, GAS OR WATER RECORDS

CASING RECORD

FORMATION	CONTENT	FROM	TO	5/8 SIZE	PUT IN	PULLED OUT
Mississippi	Oil, Water, Gas	5158	5200	5 1/2	cased	none
Kansas City	Water	4937	4943	5 1/2	cased	none
Kansas City	Water	4769	4772	5 1/2	cased	none
Kansas City	Water	4700	4704	5 1/2	cased	none

Describe in detail the manner in which the well was plugged, indicating where the mud fluid was placed and the method or methods used in introducing it into the hole. If cement or other plugs were used, state the character of same and depth placed, from feet to feet for each plug set.

Bridge Plug set above all perforations at 4600', dumped 5- sacks cement.

From 340- feet, put in a 20- foot Rock Bridge, filled hole with 6-yds- Ready - mix

RECEIVED
STATE CORPORATION COMMISSION
NOV 5 1964
11-05-1964
CONSERVATION DIVISION
Wichita, Kansas

(If additional description is necessary, use BACK of this sheet)

Name of Plugging Contractor LYNCH CASING PULLING COMPANY NO. 457

Address R.R. 4 GREAT BEND, KANSAS

STATE OF KANSAS, COUNTY OF BARTON, ss.

Jim Harrison (employee of owner) or (owner or operator) of the above-described well, being first duly sworn on oath, says: That I have knowledge of the facts, statements, and matters herein contained and the log of the above-described well as filed and that the same are true and correct. So help me God.

(Signature) Jim Harrison

(Address)

SUBSCRIBED AND SWORN TO before me this 4th day of November, 1964

My commission expires July 31, 1966

Mary M. Guesnier
Mary M. Guesnier Notary Public.

15-033-30060-00-00

WELL LOG - - - - - Victory Life #1

LOCATED: SE NW Section 2-32S-16W, Comanche Co., Kansas

OWNER: Livingston Oil
ROTARY DRILLING CONTRACTOR: Sterling Drilling Company

COMMENCED: July 24, 1964
COMPLETED: August 26, 1964

ROTARY TOTAL DEPTH: 6117'

LOG

0 -	85	Sand
210 -	500	Red Bed & Sand Stone
500 -	635	Red Bed
635 -	995	Shale
995 -	1700	Red Bed & Shale
1700 -	2300	Shale & Shells
2300 -	2600	Lime & Shale
2600 -	2694	Shale
2694 -	2815	Shale & Shells
2815 -	2900	Lime
2900 -	4325	Lime & Shale
4325 -	4380	Lime
4380 -	4490	Shale & Lime
4490 -	5320	Lime
5320 -	5388	Lime & Chert
5388 -	5425	Lime
5425 -	5476	Lime & Chert
5476 -	5504	Lime
5504 -	5525	Lime & Chert
5525 -	5599	Lime
5599 -	5628	Shale & Lime
5628 -	5665	Lime & Chert
5665 -	5681	Lime
5681 -	5685	Sand & Lime
5685 -	5724	Lime & Chert
5724 -	5855	Lime
5855 -	5865	Lime & Sand
5865 -	5922	Sand & Shale
5922 -	5938	Lime
5938 -	5948	Sand
5948 -	5967	Lime
5967 -	6027	Sand & Shale
6027 -	6055	Lime & Shale
6055 -	6117	Lime

CASING RECORD

Set 10 3/4" Surface Casing at 628.49 K.B.
with 600 sacks, 50-50 Pozmix with 2% c.c.

RECEIVED
STATE CORPORATION COMMISSION

JAN 13 1965
01-13-1965
CONSERVATION DIVISION
Wichita, Kansas

Run 5 1/2" casing at 5336' cemented with
220 sacks of regular cement.