


WELL PLUGGING RECORD

Give All Information Completely  
Make Required Affidavit  
Mail or Deliver Report to:  
Conservation Division  
State Corporation Commission  
211 No. Broadway  
Wichita, Kansas

COMANCHE County. Sec. 15 Twp. 32S Rge. 18W (X) (W)

Location as "NE/CNW%SW%" or footage from lines APPROX. C NE SW  
Lease Owner PETROLEUM, INC.,  
Lease Name BLACKARD Well No. 1  
Office Address ROUTE 2, GREAT BEND, KANSAS  
Character of Well (completed as Oil, Gas or Dry Hole) DRY HOLE  
Date well completed JULY 12, 19 63  
Application for plugging filed JULY 12, 19 63  
Application for plugging approved JULY 12, 19 63  
Plugging commenced JULY 12, 19 63  
Plugging completed JULY 12, 19 63  
Reason for abandonment of well or producing formation NO PRODUCIBLE FORMATIONS

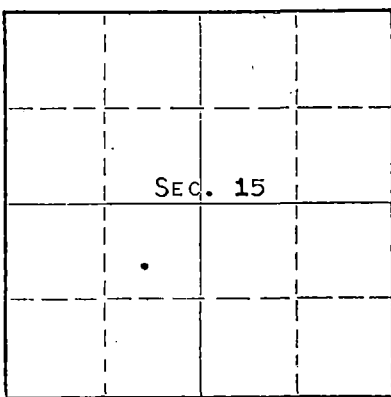

Locate well correctly on above Section Plat

If a producing well is abandoned, date of last production NONE 19  
Was permission obtained from the Conservation Division or its agents before plugging was commenced? YES

Name of Conservation Agent who supervised plugging of this well ARCHIE ELVING  
Producing formation - - Depth to top - - Bottom - - Total Depth of Well 5210 Feet  
Show depth and thickness of all water, oil and gas formations.

OIL, GAS OR WATER RECORDS

CASING RECORD

FORMATION	CONTENT	FROM	TO	SIZE	PUT IN	PULLED OUT
				8-5/8"	572'	NONE

Describe in detail the manner in which the well was plugged, indicating where the mud fluid was placed and the method or methods used in introducing it into the hole. If cement or other plugs were used, state the character of same and depth placed, from \_\_\_\_\_ feet to \_\_\_\_\_ feet for each plug set.

MUDDED UP WITH HEAVY MUD TO 275' FOLLOWED BY WOODEN PLUG AND 2 SACKS HULLS. PLACED 20 SACKS CEMENT THROUGH DRILL PIPE ONTO HULLS. MUDDED UP WITH HEAVY MUD TO 40', FOLLOWED BY WOODEN PLUG, 2 SACKS HULLS AND 10 SACKS CEMENT TO BASE OF WELL CELLAR. PLACED 2 SACKS CEMENT IN RAT HOLE AND 2 SACKS CEMENT IN MOUSE HOLE.

RECEIVED  
STATE CORPORATION COMMISSION

JUL 23 1963  
07-23-1963

CONSERVATION DIVISION  
Wichita, Kansas

(If additional description is necessary, use BACK of this sheet)  
Name of Plugging Contractor GARVEY DRILLING COMPANY  
Address ROUTE 2, GREAT BEND, KANSAS

STATE OF KANSAS, COUNTY OF BARTON, ss.  
DON SEARLE (employee of owner) or (owner or operator) of the above-described

well, being first duly sworn on oath, says: That I have knowledge of the facts, statements, and matters herein contained and the log of the above-described well as filed and that the same are true and correct. So help me God.

(Signature) DON SEARLE, DIST. PROD. SUPT.  
ROUTE 2, GREAT BEND, KANSAS  
(Address)

SUBSCRIBED AND SWORN TO before me this 19TH day of JULY, 19 63

My commission expires APRIL 14, 1967 Archie J. Wiles Notary Public.

# WELL LOG

15-033-10026-00-00

COMPANY **Petroleum Incorporated**

SEC. 15 T. 32S R. 18W

FARM **Blackard** NO. **1**

LOC. **C-NE-SW**

TOTAL DEPTH **5210'**

COUNTY **Comanche**

COMM. **6-29-63**

COMP. **7-12-63**

CONTRACTOR **Garvey Drilling Company**


CASING **8 5/8" @ 572' w/400 sx**

ELEVATION **2081' K.B.**

PRODUCTION **D & A**

FIGURES INDICATE BOTTOM OF FORMATIONS

- 200' Surface Soil and Sand
- 585' Red Bed and Sand
- 993' Red Bed and Shale
- 1630' Red Bed
- 2390' Shale and Shells
- 2715' Lime and Shale
- 2810' Shale
- 3043' Lime and Shale
- 3198' Shale, Lime and Sand
- 3717' Shale and Lime
- 4455' Lime and Shale
- 5034' Lime
- 5084' Lime (Marmaton)
- 5210' Lime
- 5210' RTD

**RECEIVED**  
STATE CORPORATION COMMISSION

JUL 23 1963  
07-23-1963  
CONSERVATION DIVISION  
Wichita, Kansas

State of Kansas }  
County of Barton } SS

I, Sam N. Stephens of Garvey Drilling Company

upon oath state the above and foregoing is a true and correct copy of the log of the Blackard #1 well.

*Sam N. Stephens*

Subscribed and sworn to before me this 18th day of July 19 63

My Commission Expires: April 14th, 1967

*Arthur J. Wiles*  
NOTARY PUBLIC