


STATE OF KANSAS
STATE CORPORATION COMMISSION

Give All Information Completely
Make Required Affidavit
Mail or Deliver Report to:
Conservation Division
State Corporation Commission
211 No. Broadway
Wichita, Kansas

WELL PLUGGING RECORD

Comanche County. Sec. 23 Twp. 32 Rge. (S) 12 (W)
Location as "NE/CNW/SW" or footage from lines SE, NW.
Lease Owner Aladdin Petroleum Corporation
Lease Name Bealey Parcel Unit Well No. 1
Office Address 809 Petroleum Bldg. Wichita 2, Kansas
Character of Well (completed as Oil, Gas or Dry Hole) Dry Hole
Date well completed November 9th 1962
Application for plugging filed Verbal November 9th 1962
Application for plugging approved Verbal November 9th 1962
Plugging commenced November 9th 1962
Plugging completed November 9th 1962
Reason for abandonment of well or producing formation Dry Hole

NORTH

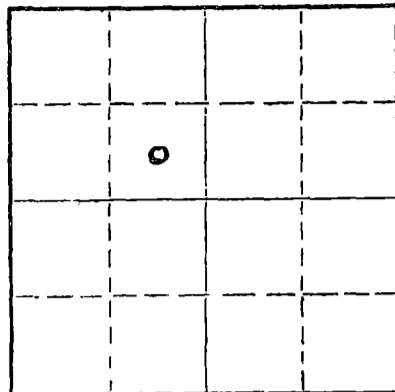

Locate well correctly on above
Section Plat

If a producing well is abandoned, date of last production None 19
Was permission obtained from the Conservation Division or its agents before plugging was commenced? Yes

Name of Conservation Agent who supervised plugging of this well Verbal W. K. Lackamp
Producing formation _____ Depth to top _____ Bottom _____ Total Depth of Well 5850 Feet
Show depth and thickness of all water, oil and gas formations.

OIL, GAS OR WATER RECORDS

CASING RECORD

FORMATION	CONTENT	FROM	TO	SIZE	PUT IN	PULLED OUT
				20"	At 37'	None
				13 3/8"	At 485'	None

Describe in detail the manner in which the well was plugged, indicating where the mud fluid was placed and the method or methods used in introducing it into the hole. If cement or other plugs were used, state the character of same and depth placed, from _____ feet to _____ feet for each plug set.

Filled Hole to 450 feet with Heavy Mud, Set Bridge Plug at 450 feet with 1/4 Sax Hulls and 35 Sax Cement on Plug. Filled Hole with Heavy Mud to 40 feet from bpttpm pf collar, Set Bridge Plug. 15 sax cement on Plug to bottom of collar.

RECEIVED
STATE CORPORATION COMMISSION
SEP 13 1963
09-13-1963
CONSERVATION DIVISION
Wichita, Kansas

(If additional description is necessary, use BACK of this sheet)

Name of Plugging Contractor Patton Drilling Company, Inc.
Address 505 Orpheum Bldg. Wichita 2, Kansas.

STATE OF Kansas COUNTY OF Sedgwick, ss.
R. W. Patton (employee of owner) ~~owner~~ of the above-described well, being first duly sworn on oath, says: That I have knowledge of the facts, statements, and matters herein contained and the log of the above-described well as filed and that the same are true and correct. So help me God.

(Signature) R. W. Patton
505 Orpheum Bldg. Wichita 2, Kansas.
(Address)

SUBSCRIBED AND SWORN TO before me this 14th day of November, 1962
T. P. Hendrick
My commission expires October 4th 1964

Aladdin Petroleum Corporation
 Beeley Parcel Unit Well # 1
 Total Depth 5880'
 Comm 12/11/62
 Rotary Comp. 11/9/62
 Contractor
 Patton Drilling Company, Inc.

15-033-10000-00-00
 Location 2 1/2 NW, Section 25-32S-R10W
 Comanche County, Kansas.
 CASING RECORD
 8 1/2" Casing at 37'
 Cemented with 50 Saz
 13 3/8" Casing at 485'
 Cemented with 500 Saz.

Sand	115
Shale & Shells	185
Red Clay	290
Red Bed	350
Red Bed & Gypsum Shells	493
Red Bed	1450
Red Bed & Anhydrite	2032
Red Bed & Lime	2303
Lime & Shale	2378
Lime	2641
Lime & Shale	2751
Lime	2978
Lime & Shale	3623
Lime 3785	3785
Lime & Shale	4349
Sandy Lime & Shale	4465
Lime & Shale	4556
Lime	4898
Lime & Shale	5165
Lime W/Chert & Shale	5180
Cherty Lime & Shale	5190
Lime	5880
Total Depth	5880

RECEIVED
 STATE CORPORATION COMMISSION

SEP 13 1963
 09-13-1963
 CONSERVATION DIVISION
 Wichita, Kansas

STATE OF Kansas COUNTY OF Sedgewick ss.

I, the undersigned, being duly sworn, on oath state that the above statement and log is a true and correct record and log of the well drilled at the location above described.

PATTON DRILLING COMPANY, INC.

By Robert W. Patton

Subscribed and sworn to before me this 14th day of November 1962

T. P. Hendrick
 T. P. Hendrick Notary Public

My Commission expires Oct 4th 1964