

STATE OF KANSAS
STATE CORPORATION COMMISSION

Give All Information Completely
Make Required Affidavit
Mail or Deliver Report to:
Conservation Division
State Corporation Commission
212 No. Market
Wichita, Kansas

WELL PLUGGING RECORD

Comanche County, Sec. 26 Twp. 31 Rge. 18 (E) (W)

Location as "NE/CNW $\frac{1}{2}$ SW $\frac{1}{2}$ " or footage from lines NE NE

Lease Owner Blaik Oil Company

Lease Name Emerick Well No. 1-26

Office Address 203 Park Avenue, Oklahoma City, Oklahoma 73102

Character of Well (completed as Oil, Gas or Dry Hole) Oil

Date well completed May 22, 1969

Application for plugging filed May 8, 1970

Application for plugging approved May 13, 1970


Plugging commenced June 5, 1970

Plugging completed June 11 1970

Reason for abandonment of well or producing formation Depletion

If a producing well is abandoned, date of last production May 7, 1970

Was permission obtained from the Conservation Division or its agents before plugging was commenced? yes

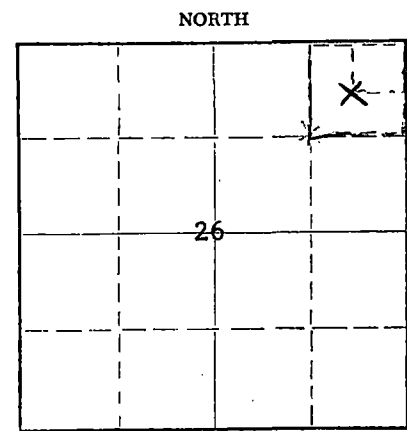

Locate well correctly on above Section Plat

Name of Conservation Agent who supervised plugging of this well Russell Biberstein, Atica, Kansas 67009

Producing formation Mississippi Depth to top 5100 Bottom 5130 Total Depth of Well 5304' Feet

Show depth and thickness of all water, oil and gas formations.

OIL, GAS OR WATER RECORDS

CASING RECORD

FORMATION	CONTENT	FROM	TO	SIZE	PUT IN	PULLED OUT
				8-5/8"	450	None
				4-1/2	5290	3236

Describe in detail the manner in which the well was plugged, indicating where the mud fluid was placed and the method or methods used in introducing it into the hole. If cement or other plugs were used, state the character of same and depth placed, from _____ feet to _____ feet for each plug set.

June 5, 1970, Plugged off bottom. Dumped sand to 5000', mixed and dumped 4 sks of cement to 4950'.

June 11, 1970, Plugged off top. set 10' rock bridge from 260' to 270'. Mixed and dumped 25 sks of cement from 260' to 185', Mudded casing from 185' to 40'. Set 10' rock bridge from 40' to 30', mixed and dumped 10 sks of cement from 30' to base of cellar.

RECEIVED
STATE CORPORATION COMMISSION
7-6-70
JUL 6 1970
CONSERVATION DIVISION
Wichita, Kansas

(If additional description is necessary, use BACK of this sheet)

Name of Plugging Contractor Russ Casing Pulling, Inc.

Address P. O. Box 1082, Great Bend, Kansas 67530

STATE OF Oklahoma, COUNTY OF Oklahoma, ss.
Hilde Roberts, Production Sec'y (~~employee of owner~~) or (owner or operator) of the above-described well, being first duly sworn on oath, says: That I have knowledge of the facts, statements, and matters herein contained and the log of the above-described well as filed and that the same are true and correct. So help me God.

(Signature) Hilde Roberts
203 Park Avenue, Oklahoma City, Oklahoma
(Address)

SUBSCRIBED AND SWORN TO before me this 2 day of July, 19 70

My commission expires 2/17/74
Carolyn B. Chamberlain
Notary Public.