


15-033-20018-0001

STATE OF KANSAS
STATE CORPORATION COMMISSION
Give All Information Completely
Make Required Affidavit
Mail or Deliver Report to:
Conservation Division
State Corporation Commission
211 No. Broadway
Wichita, Kansas

Form CP-4

WELL PLUGGING RECORD

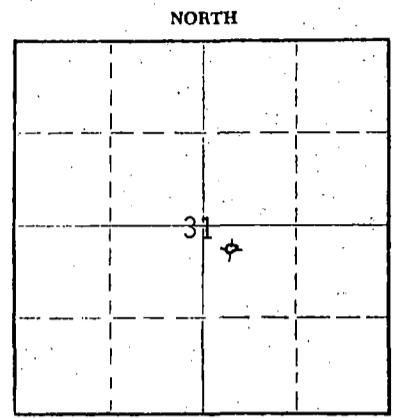

Locate well correctly on above Section Plot

Comanche County, Sec. 31 Twp. 31S Rge. 5 (E) 18 (W)

Location as "NE/CNW/SW" or footage from lines NW NW SE OWWO

Lease Owner Hershberger Explorations, Inc.

Lease Name YOST Well No. 1

Office Address Suite 230, 200 W. Douglas, Wichita, Kansas 67202

Character of Well (completed as Oil, Gas or Dry Hole) Dry hole.

Date well completed 7-10 1972

Application for plugging filed 7-14 1972

Application for plugging approved 7-17 1972

Plugging commenced 7-19 1972

Plugging completed 8-9 1972

Reason for abandonment of well or producing formation Dry hole

If a producing well is abandoned, date of last production ----- 19 --

Was permission obtained from the Conservation Division or its agents before plugging was commenced? Yes

Name of Conservation Agent who supervised plugging of this well G. Russell Biberstein, Attica, Kansas 67009

Producing formation _____ Depth to top _____ Bottom _____ Total Depth of Well 5397 Feet

Show depth and thickness of all water, oil and gas formations.

OIL, GAS OR WATER RECORDS

CASING RECORD

FORMATION	CONTENT	FROM	TO	SIZE	PUT IN	PULLED OUT
				8 5/8"	419'	None
				4 1/2"	5250'	3000'

Describe in detail the manner in which the well was plugged, indicating where the mud fluid was placed and the method or methods used in introducing it into the hole. If cement or other plugs were used, state the character of same and depth placed, from _____ feet to _____ feet for each plug set.

Well plugged back to 5220'.
 Dump sand in from 5220 to 5130.
 Dump four sacks of cement with dump bailer, cement from 5130 to 5100.
 Ripped 4 1/2" at 4000 = 3500 and 3000.
 Bridge at 200 feet.
 Rock from 200 to 190.
 25 sacks cement from 190 to 115
 Mud from 115 to 40
 Rock from 40 to 30
 10 sacks cement from 30 to surface.

RECEIVED
 STATE CORPORATION COMMISSION
 SEP 13 1972
 9-13-72
 CONSERVATION DIVISION
 Wichita, Kansas

(If additional description is necessary, use BACK of this sheet)

Name of Plugging Contractor Clarke Corp.

Address Box 187, Medicine Lodge, Kansas

STATE OF Kansas, COUNTY OF Sedgwick, ss.

Loren E. Lake (employee of owner) or (owner or operator) of the above-described well, being first duly sworn on oath, says: That I have knowledge of the facts, statements, and matters herein contained and the log of the above-described well as filed and that the same are true and correct. So help me God.

(Signature) Loren E. Lake
Suite 230, 200 West Douglas, Wichita, Kans.
 (Address) 67202

SUBSCRIBED AND SWORN to before me this 11th day of September, 1972

Marguerite Mayfield
 Notary Public.

10-26-73

