

STATE OF KANSAS
STATE CORPORATION COMMISSION

WELL PLUGGING RECORD

Give All Information Completely
Make Required Affidavit
Mail or Deliver Report to
Conservation Division
State Corporation Comm.
245 North Water
Wichita, KS 67202

Comanche County. Sec. 12 Twp. 31S Rge. 18W E/W
Location as "NE/CNW $\frac{1}{4}$ SW $\frac{1}{4}$ " or footage from lines
SE SE

Lease Owner Petroleum, Inc.

Lease Name BOOTHE "E" Well No. 1

Office Address 800 R. H. Garvey Bldg, Wichita, Ks. 67202

Character of Well (Completed as Oil, Gas or Dry Hole)
Dry Hole

Date Well completed 2-05 1977

Application for plugging filed (Verbally) 2-05 1977

Application for plugging approved (Verbally) 2-05-1977

Plugging commenced 2-05-1977


Plugging completed 2-05 1977

Reason for abandonment of well or producing formation

No commercial quantity of oil or gas encountered

If a producing well is abandoned, date of last production
19

Was permission obtained from the Conservation Division or
its agents before plugging was commenced? Yes

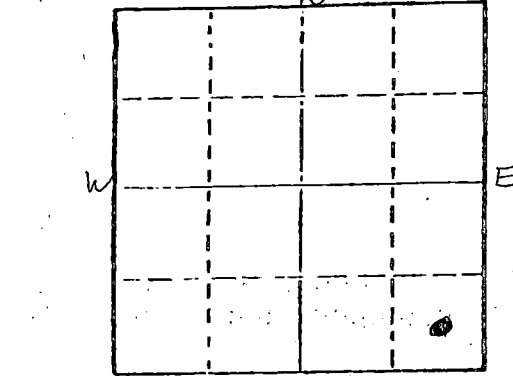

Locate well correctly on above
Section Plat

Name of Conservation Agent who supervised plugging of this well Clarence Thomas

Producing formation _____ Depth to top _____ Bottom _____ Total Depth of Well _____

Show depth and thickness of all water, oil and gas formations.

OIL, GAS OR WATER RECORDS

CASING RECORD

FORMATION	CONTENT	FROM	TO	SIZE	PUT IN	PULLED OUT

Describe in detail the manner in which the well was plugged, indicating where the mud fluid was placed and the method or methods used in introducing it into the hold. If cement or other plugs were used, state the character of same and depth placed, from _____ feet to _____ feet for each plug set.

T.D. 5100'
Set 1st plug at 500' with 50 sx.,
Set 2nd plug at 40' with 10 sx.
Rathole - 5' sx.

Plug was down at 11:00 p.m. 2-05-77
State Plugger - Clarence Thomas

RECEIVED
STATE CORPORATION COMMISSION

FEB 14 1977
2-14-77
CONSERVATION DIVISION
Wichita, Kansas

(If additional description is necessary, use BACK of this sheet)

Name of Plugging Contractor Abercrombie Drilling, Inc.

STATE OF Kansas COUNTY OF Sedgwick ss.

Jack L. Partridge, Asst. Sec.-Treas. (employee of owner) or (owner or operator) of the above-described

well, being first duly sworn on oath, says: That I have knowledge of the facts, statements, and matters herein contained and the log of the above-described well as filed and that the same are true and correct. So help me God.

(Signature) Jack L. Partridge

801 Union Center, Wichita, Ks. 67202


(Address)

Subscribed and Sworn to before me this 10th day of February 1977

My commission expires _____

Kathy S. Goertz
Notary Public

Notary Public.

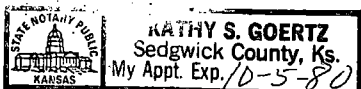

CONTRACTOR'S WELL LOG

OPERATOR:	Petroleum, Inc.
CONTRACTOR:	Abercrombie Drilling, Inc.
WELL NAME:	BOOTHE "E" #1
LOCATION:	SE SE, Section 12-31S-18W Comanche County, Kansas
SPUD DATE:	1-14-77
COMPLETION DATE:	2-05-77

0	70	Gypsum
70	190	Sand
190	1170	Sand & Shale
1170	1372	Shale & Shells
1372	1615	Shale
1615	2176	Lime & Shale
2176	4270	Shale & Lime
4270	4350	Lime & Shale
4350	5100	Lime
	5100	Rotary Total Depth

Spud hole at 10:45 a.m. 1-14-77. Drilled 625' of 12 1/4" hole. Ratholed ahead 7 7/8" hole to 1440'. (Tally 598.89') Ran new 8 5/8" - 20# Surface Casing. Set at 607'. Cemented with 250 sx. of 50/50 posmix, 4% gel, 3% Ca. Cl. followed with 200 sx. common cement, 3% Ca. Cl., 2% gel. Cement did circulate. Job complete at 3:30 p.m. 1-15-77

T.D. 5100', Set 1st plug at 500' with 50 sx., set 2nd plug at 40' with 10 sx., Rathole - 5 sx. Plug was down at 11:00 p.m. 2-05-77. Cemented with Common - Sun Cement. State Plugger - Clarence Thomas.

STATE OF KANSAS)
) SS
 COUNTY OF SEDGWICK)

Jack L. Partridge, Assistant Secretary-Treasurer of Abercrombie Drilling, Inc., does hereby state that the above and foregoing is a true and correct log of the BOOTHE "E" #1, SE SE, Section 12-31S-18W, Comanche County, Kansas.

ABERCROMBIE DRILLING, INC.

STATE COMMISSIONER OF GEOLOGY

FEB 14 1977
 2-14-77
 COMMISSIONER OF GEOLOGY
 Topeka, Kansas

BY: Jack L. Partridge
 Jack L. Partridge, Asst. Sec.-Treas.

Subscribed and sworn to before me, a Notary Public, in and for the aforesaid county and state as of this 10th day of February, 1977.

Kathy S. Goertz
 Kathy S. Goertz, Notary Public

