


STATE OF KANSAS
STATE CORPORATION COMMISSION

WELL PLUGGING RECORD

Give All Information Completely
Make Required Affidavit
Mail or Deliver Report to
Conservation Division
State Corporation Comm.
245 North Water
Wichita, KS 67202

Comanche County. Sec. 12 Twp. 31S Rge. 18 XX/W
Location as "NE/CNW $\frac{1}{4}$ SW $\frac{1}{4}$ " or footage from lines
C NE NE
Lease Owner Maurice L. Brown Company
Lease Name LOESCH "A" Well No. 1
Office Address 200 Sutton Place, Wichita, Kansas
Character of Well (Completed as Oil, Gas or Dry Hole)
Dry Hole

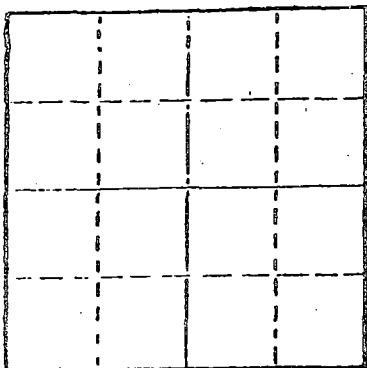

Locate well correctly on above
Section Plat

Date Well completed 08-17-1980
Application for plugging filed 08-17-1980
Application for plugging approved 08-17-1980
Plugging commenced 08-17-1980
Plugging completed 08-17-1980
Reason for abandonment of well or producing formation
No commercial quantity of oil or gas
If a producing well is abandoned, date of last production
19

Was permission obtained from the Conservation Division or
its agents before plugging was commenced? Yes

Name of Conservation Agent who supervised plugging of this well Bill Owens
Producing formation _____ Depth to top _____ Bottom _____ Total Depth of Well 5120
Show depth and thickness of all water, oil and gas formations.

OIL, GAS OR WATER RECORDS

CASING RECORD

FORMATION	CONTENT	FROM	TO	SIZE	PUT IN	PULLED OUT

Describe in detail the manner in which the well was plugged, indicating where the mud fluid
was placed and the method or methods used in introducing it into the hold. If cement or other
plugs were used, state the character of same and depth placed, from _____ feet to
_____ feet for each plug set.

T.D. 5120'

Set 1st plug at 1020' with 50 sx.
2nd plug at 40' solid bridge with 10 sx.
Rathole with 5 sx. 50/50 posmix, 6% gel.

Plug was down at 8:00 p.m. 08-17-80.

RECEIVED
STATE CORPORATION COMMISSION
8-25-80
AUG 25 1980
CONSERVATION DIVISION
Wichita, Kansas

(If additional description is necessary, use BACK of this sheet)

Name of Plugging Contractor _____

STATE OF Kansas COUNTY OF Sedgwick, ss.
Jack L. Partridge, Asst. Sec.-Treas. (employee of owner) or (owner or operator)
of the above-described well, being first duly sworn on oath, says: That I have knowledge of
the facts, statements, and matters herein contained and the log of the above-described well
as filed and that the same are true and correct. So help me God.

(Signature) Jack L. Partridge
801 Union Center, Wichita, Kansas
(Address)

SUBSCRIBED AND SWORN TO before me this 21st day of August, 1980

My commission expires _____



Sherrie L. Brooks
Sherrie L. Brooks Notary Public.

CONTRACTOR'S WELL LOG

OPERATOR:	Maurice L. Brown Company
CONTRACTOR:	Abercrombie Drilling, Inc.
WELL NAME:	LOESCH "A" #1
LOCATION:	C NE NE, Section 12-31S-18W Comanche County, Kansas
SPUD DATE:	07-30-80
COMPLETION DATE:	08-17-80

0	200	Sand & Red Bed
200	1070	Red Bed & Shale
1070	1532	Red Bed, Lime & Shale
1532	5120	Lime & Shale
	5120	Rotary Total Depth

Spud hole @ 4:45 p.m. 07-30-80. Drilled 200' of a 17-1/4" hole. Ran 5 joints 198' of 13-3/8" 45# casing. Set at 198'. Cemented with 275 sx. of common, 2% gel, 3% c.c. Cement did circulate. Plug was down at 1:45 a.m. 07-31-80.

T.D. 5120'. Set 1st plug at 1020' with 50 sx. Set 2nd plug at 40' solid bridge with 10 sx. Rathole with 5 sx. 50/50 posmix, 6% gel. Plug was down @ 8:00 p.m. 08-17-80.

STATE OF KANSAS)
) SS
 COUNTY OF SEDGWICK)

Jack L. Partridge, Assistant Secretary-Treasurer of Abercrombie Drilling, Inc., does hereby state that the above and foregoing is a true and correct copy of the log of the LOESCH "A" #1, C NE NE, Section 12-31S-18W, Comanche County, Kansas.

ABERCROMBIE DRILLING, INC.

BY: Jack L. Partridge
 Jack L. Partridge, Asst. Sec.-Treas.

Subscribed and sworn to before me, a Notary Public, in and for the aforesaid county and state as of this 21st day of August, 1980.

Sherrie L. Brooks
 Sherrie L. Brooks, Notary Public

RECEIVED
 STATE CORPORATION COMMISSION
 AUG 25 1980
 8-25-80
 CONSERVATION DIVISION
 Wichita, Kansas