


Give All Information Completely  
Make Required Affidavit  
Mail or Deliver Report to:  
Conservation Division  
State Corporation Commission  
211 No. Broadway  
Wichita, Kansas

WELL PLUGGING RECORD

NORTH

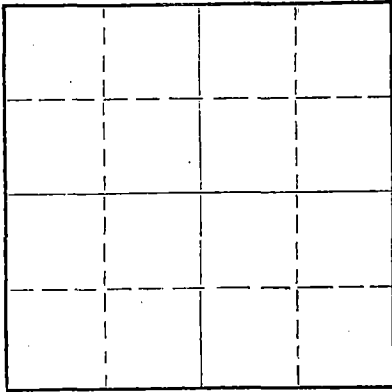

Locate well correctly on above  
Section Plat

Comanche County, Sec. 5 Twp. 31S Rge. 18W (E) (W)

Location as "NE/CNW/SW" or footage from lines 150- NW of c NW NE

Lease Owner Wm. H. Pine

Lease Name Robinson Well No. 1-A

Office Address Okmulgee, Okla.

Character of Well (completed as Oil, Gas or Dry Hole) Dry Hole

Date well completed July 25 19 65

Application for plugging filed July 29 19 65

Application for plugging approved July 25 19 65

Plugging commenced July 25 19 65

Plugging completed July 25 19 65

Reason for abandonment of well or producing formation Dry Hole

If a producing well is abandoned, date of last production 19

Was permission obtained from the Conservation Division or its agents before plugging was commenced? Yes

Name of Conservation Agent who supervised plugging of this well Archie V. Elving, Pratt, Kansas

Producing formation Depth to top Bottom Total Depth of Well Feet

Show depth and thickness of all water, oil and gas formations.

OIL, GAS OR WATER RECORDS

CASING RECORD

FORMATION	CONTENT	FROM	TO	SIZE	PUT IN	PULLED OUT
		0	612'	10 3/4"	612'	None

Describe in detail the manner in which the well was plugged, indicating where the mud fluid was placed and the method or methods used in introducing it into the hole. If cement or other plugs were used, state the character of same and depth placed, from feet to feet for each plug set.

Set Plug @ 350'/25 sacks cement and 1/2 sacks hulls  
40'/10 sacks cement and 1/2 sack hulls

RECEIVED  
STATE CORPORATION COMMISSION

JUL 30 1965  
7-30-65  
CONSERVATION DIVISION  
Wichita, Kansas

(If additional description is necessary, use BACK of this sheet)

Name of Plugging Contractor Hellar Drilling Company, Inc.

Address 1014 Union Center, Wichita, Kansas, 67202

STATE OF Kansas, COUNTY OF Sedgwick, ss.

D. L. Hellar, Pres. of Hellar Drilling Co. Inq (employee of owner) or (owner or operator) of the above-described well, being first duly sworn on oath, says: That I have knowledge of the facts, statements, and matters herein contained and the log of the above-described well as filed and that the same are true and correct. So help me God.

(Signature) D. L. Hellar D. L. Hellar, President  
1014 Union Center, Wichita, Kansas (Address)

SUBSCRIBED AND SWORN TO before me this 29th day of July 19 65

My commission expires March 25, 1968.

Catherine Darcey  
Catherine Darcey - Notary Public.

DRILLER'S LOG

COMPANY: Wm. H. Pine, Okmulgee, Okla.  
 CONTRACTOR: Hellar Drilling Company, Inc., Wichita, Kansas  
 LEASE: #1-A Robinson  
 LOCATION: 150' NW of c NW NE 5-31S-18W, Comanche County, Kansas  
 COMMENCED: July 7, 1965  
 COMPLETED: July 25, 1965  
 CASING: Set 10 3/4" surface casing @ 612'/370 sacks cement

0-415	Surface sand and shale
415-1115	Shale & Red Bed & shells
1115-1820	Shale & Red Bed
1820-2130	Salt Section
2130-2312	Salt Section & shells
2312-2450	Lime & shale
2450-2462	Shale & Lime
2462-2534	Lime & shale
2534-2609	Ft. Riley section
2609-2734	Lime & shale
2734-2892	Ft. Riley
2892-3040	Lime & shale
3040-3175	Shale & lime
3175-3271	Lime & shale
3271-3395	Shale & lime stks.
3395-3498	Shale & lime
3498-3648	Lime & lime
3648-3905	Lime & shale
3905-3984	Lime & shale streaks
3984-4302	Lime & shale
4302-4383	Douglas shale
4383-4388	Br. Lime
4388-4403	Shale
4403-4417	Lansing
4417-4490	Lsg. -K.C.
4490-4533	Lime (K.C.)
4533-4607	K.C. Lime
4607-4672	Lsg. K.C.
4672-4712	Lime
4712-4965	Lime & shale
4965-4972	Lime
4972-5053	Lime & shale
5053-5065	Lime (sandy)
5065-5088	Mississippian
5088-5110	Lime-chert
5110	Rotary Total Depth D & A

RECEIVED  
STATE CORPORATION COMMISSION

JUL 30 1965  
7-30-65  
CONSERVATION DIVISION  
Wichita, Kansas

STATE OF KANSAS )  
 ) SS  
 COUNTY OF SEDGWICK )

I, D. L. Hellar, do hereby certify that the above and foregoing is a true and correct copy of the log of the #1-A Robinson, located 150' NW of c NW NE 5-31S-18W, Comanche County, Kansas, as reflected by the files of the Hellar Drilling Company, Inc.

HELLAR DRILLING COMPANY, INC.

By D. L. Hellar  
 President - D. L. Hellar

Subscribed and sworn to before me, a Notary Public, in and for Sedgwick County, Kansas, this 29th day of July, 1965.

My Commission Expires:  
 March 25, 1968.

Catherine Darcéy  
 Notary Public - Catherine Darcéy