

STATE OF KANSAS
STATE CORPORATION COMMISSION

WELL PLUGGING RECORD

Give All Information Completely
Make Required Affidavit
Mail or Deliver Report to
Conservation Division
State Corporation Comm.
245 North Water
Wichita, KS 67202

Comanche County, Sec. 5 Twp. 315 Rge. 18W E/W
Location as "NE/CNW 1/4 SW 1/4" or footage from lines
NW/4 NW/4 SW/4


Lease Owner Altman Operating Company
Lease Name Robinson Well No. 2
Office Address 4th Nat'l Bank Bldg., Suite 1901, Tulsa, OK 74119
Character of Well (Completed as Oil, Gas or Dry Hole)
Dry Hole

Date Well completed 4/6 1981
Application for plugging filed 4/6 1981
Application for plugging approved 4/6 1981
Plugging commenced 4/6 1981
Plugging completed 4/6 1981
Reason for abandonment of well or producing formation

If a producing well is abandoned, date of last production 19

Was permission obtained from the Conservation Division or its agents before plugging was commenced? Yes

Name of Conservation Agent who supervised plugging of this well Maurice Leasley
Producing formation Depth to top Bottom Total Depth of Well
Show depth and thickness of all water, oil and gas formations.

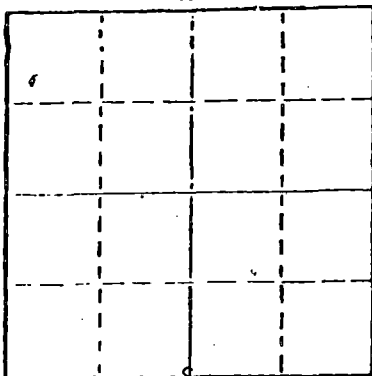

Locate well correctly on above Section Plat

OIL, GAS OR WATER RECORDS

CASING RECORD


FORMATION	CONTENT	FROM	TO	SIZE	PUT IN	PULLED OUT
Red Bed		0'	650'	8 5/8"	15 jnts	

Describe in detail the manner in which the well was plugged, indicating where the mud fluid was placed and the method or methods used in introducing it into the hold. If cement or other plugs were used, state the character of same and depth placed, from feet to feet for each plug set. Cement was circulated, plugged with 50 sacks common & plug at 620 feet, 20 sacks common on top, 10 sacks common in mouse hole and 10 sacks common in rat hole. Completed April 6, 1981 at 2 A. M.

(If additional description is necessary, use BACK of this sheet)

Name of Plugging Contractor

STATE OF Kansas COUNTY OF Sedgwick, ss.
Kirby C. Evers, Vice-President (employee of owner) or (owner or operator)
of the above-described well, being first duly sworn on oath, says: That I have knowledge of the facts, statements and matters herein contained and the log of the above-described well as filed and that the same are true and correct. So help me God.

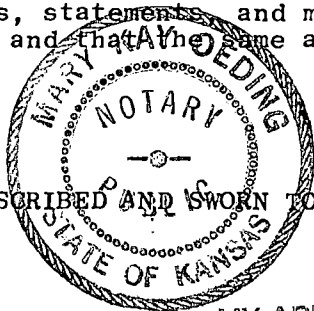

(Signature) Kirby C. Evers
P.O. Box 18611, Wichita, Ks. 67207
(Address)

SUBSCRIBED AND SWORN TO before me this 8th day of April, 19

My commission expires MY APPOINTMENT EXPIRES NOV. 28, 1984.

Mary Kay Oeding
RECEIVED
Notary Public.
STATE CORPORATION COMMISSION
APR 13 1981
4-13-81
CONSERVATION DIVISION
Wichita, Kansas

OPERATOR: Altman Operating Company
CONTRACTOR: Xplor Drilling Company, Inc.

COMMENCED: March 26, 1981
COMPLETED: April 6, 1981
CASING RECORD: 8 5/8" at 624'

<u>FORMATION</u>	<u>FROM</u>	<u>TO</u>
Red Bed	0'	1910'
Anhy & Dolo	1910'	2363'
Lime & Shale	2363'	5150'

STATE OF KANSAS)
) SS:
COUNTY OF SEDGWICK)

I certify that this is a true and correct copy of the Driller's Log on the well drilled NW/4 NW/4 SW/4, Sec 5-315-18W, Comanche Co. Kansas to the best of my knowledge and belief.



XPLOR DRILLING COMPANY

Kirby C. Evers

Kirby C. Evers, Vice President

Subscribed and sworn to before me this 8th of April 1981.

RECEIVED
STATE CORPORATION COMMISSION

4-13-81
APR 13 1981

MY APPOINTMENT EXPIRES NOV. 28, 1984

Mary Kay Oeding
PRESERVATION DIVISION
Wichita, Kansas

My appointment expires: