

K-033-00032-0000


WELL PLUGGING RECORD

Give All Information Completely
Affidavit Required
Mail or Deliver Report to:
Conservation Division
State Corporation Commission
211 No. Broadway
Wichita, Kansas

Comanche County. Sec. 5 Twp 31S Rge. 18 (~~XXX~~) (W)

Location as "NE/CNW/SW" or footage from lines C SW SE
Lease Owner Osage Oil & Gas Co., Inc.
Lease Name Don Robinson Well No. 1
Office Address 210 Petroleum Building, Wichita, Kansas
Character of Well (completed as Oil, Gas or Dry Hole) Dry Hole
Date well completed March 15 1959
Application for plugging filed March 15 1959
Application for plugging approved March 15 1959
Plugging commenced March 15 1959
Plugging completed March 15 1959
Reason for abandonment of well or producing formation no oil in commercial quantities found
If a producing well is abandoned, date of last production _____ 19____
Was permission obtained from the Conservation Division or its agents before plugging was commenced? yes

NORTH

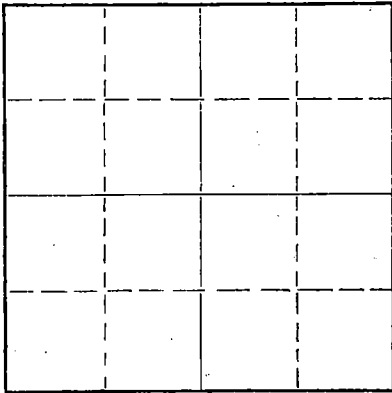

Locate well correctly on above Section Plat

Name of Conservation Agent who supervised plugging of this well Bill LeCamp
Producing formation _____ Depth to top _____ Bottom _____ Total Depth of Well 5212 Feet
Show depth and thickness of all water, oil and gas formations.

OIL, GAS OR WATER RECORDS

CASING RECORD

FORMATION	CONTENT	FROM	TO	SIZE	PUT IN	PULLED OUT
				8-5/8"	585.31'	none

Describe in detail the manner in which the well was plugged, indicating where the mud fluid was placed and the method or methods used in introducing it into the hole. If cement or other plugs were used, state the character of same and depth placed, from _____ feet to _____ feet for each plug set.

Filled hole with extra heavy rotary mud from total depth to 400'. Set Plug #1 at 400' with 20 sacks cement. Filled hole with extra heavy rotary mud from Plug #1 to 35'. Set Plug #2 at 35' with 10 sacks cement.

(If additional description is necessary, use BACK of this sheet)

Name of Plugging Contractor Capitt Drilling, Inc.
Address 814 Union Center, Wichita, Kansas

STATE OF Kansas, COUNTY OF Sedgwick, ss.
R. R. McNicol (employee of owner) or (owner or operator) of the above-described well, being first duly sworn on oath, says: That I have knowledge of the facts, statements, and matters herein contained and the log of the above-described well as filed and that the same are true and correct. So help me God.

(Signature) R. R. McNicol
814 Union Center, Wichita, Kansas
(Address)

SUBSCRIBED AND SWORN TO before me this 18th day of March, 1959

My commission expires Sept. 30, 1959

Darlene May Notary Public.

RECEIVED
STATE CORPORATION COMMISSION

PLUGGING
FILE SEC. 5 T 31 R 18w
BOOK PAGE 23 LINE 15

MAR 19 1959
3-19-59
CONSERVATION DIVISION
Wichita, Kansas

ROTARY DRILLING LOG

OPERATOR: Osage Oil & Gas Co., Inc.
 Don Robinson No. 1
 C SW SE Sec. 5-31S-18W,
 Comanche County, Kansas

CONTRACTOR: Capitt Drilling, Inc.
 COMM: 2/28/59
 COMP: 3/15/59

Formations:

Clay & Shale	120'
Sand & Sandy Shale	140'
Red Rock	320'
Shale & Red Bed	590'
Shale & Lime	595'
Red Bed	685'
Shale & Lime	960'
Shale w/Lime Streaks	1430'
Shale & Lime Streaks	1870'
Shale & Lime	2105'
Shale w/Lime Streaks	2370'
Shale & Lime Streaks	2390'
Lime	3290'
Lime & Shale	3665'
Lime	4360'
Lime & Shale	4448'
Lime	4792'
Lime with Shale	4840'
Lime	5212'
Rotary Total Depth (D&A)	5212'

Remarks: Set 585.31' of 8-5/8" surface casing at 592.31' cemented with 350 sx. common cement, 3% C.C.

We certify the above log is true and correct to the best of our knowledge and belief.

CAPITT DRILLING, INC.

R. R. McNicol
 R. R. McNicol

RECEIVED
 STATE CORPORATION COMMISSION

MAR 19 1959
 3-19-59
 CONSERVATION DIVISION
 Wichita, Kansas

PLUGGING

FILE SEC 5 T 31 R 18W
 BOOK PAGE 23 LINE 15