

STATE OF KANSAS  
STATE CORPORATION COMMISSION


WELL PLUGGING RECORD

Give All Information Completely  
Make Required Affidavit  
Mail or Deliver Report to:  
Conservation Division  
State Corporation Commission  
800 Bitting Building  
Wichita, Kansas

Comanche County, Sec. 7 Twp. 32S Rge. (E)17 (W)

Location as "NE/CNW&SW&W" or footage from lines C NW/4 NE/4  
Lease Owner Graham-Michaelis Corporation  
Lease Name Brown Well No. 1-7  
Office Address 2 P. O. Box 247, Wichita, Kansas 67201  
Character of Well (completed as Oil, Gas or Dry Hole) Dry Hole  
Date well completed December 2, 1972  
Application for plugging filed December 4, 1972  
Application for plugging approved December 4, 1972  
Plugging commenced December 2, 1972  
Plugging completed December 2, 1972  
Reason for abandonment of well or producing formation Dry Hole

NORTH

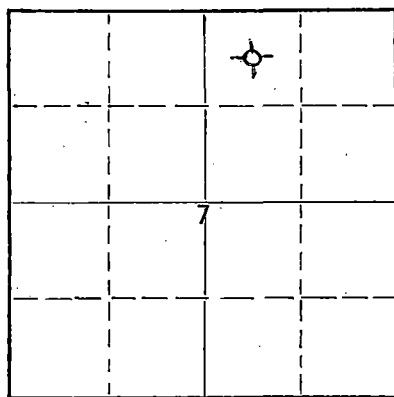

Locate well correctly on above  
Section Plat

If a producing well is abandoned, date of last production \_\_\_\_\_ 19\_\_\_\_  
Was permission obtained from the Conservation Division or its agents before plugging was commenced? Yes - verbal

Name of Conservation Agent who supervised plugging of this well G. R. Biberstein, Attica, Kansas  
Producing formation none Depth to top \_\_\_\_\_ Bottom \_\_\_\_\_ Total Depth of Well 5220 Feet  
Show depth and thickness of all water, oil and gas formations.

OIL, GAS OR WATER RECORDS

CASING RECORD

FORMATION	CONTENT	FROM	TO	SIZE	PUT IN	PULLED OUT
				8 5/8"	678'	none

Describe in detail the manner in which the well was plugged, indicating where the mud fluid was placed and the method or methods used in introducing it into the hole. If cement or other plugs were used, state the character of same and depth placed, from \_\_\_\_\_ feet to \_\_\_\_\_ feet for each plug set.

Filled hole with heavy drilling mud and put first cement plug at 450 ft. with 50 sacks cement. Mud up to 40 ft. Set plug with 15 sacks cement. Cemented by Sun Cementing Company

RECEIVED  
STATE CORPORATION COMMISSION  
DEC 7 - 1972  
12-7-72  
CONSERVATION DIVISION  
Wichita, Kansas

(If additional description is necessary, use BACK of this sheet)  
Name of Plugging Contractor Gabbert-Jones, Inc.  
Address 830 Sutton Place, Wichita, Kansas 67202

STATE OF Kansas, COUNTY OF Sedgwick, ss.  
Jack L. Yinger (employee of owner) or (owner or operator) of the above-described well, being first duly sworn on oath, says: That I have knowledge of the facts, statements, and matters herein contained and the log of the above-described well as filed and that the same are true and correct. So help me God.

(Signature) Jack L. Yinger  
P. O. Box 247, Wichita, Kansas 67201  
(Address)

SUBSCRIBED AND SWORN to before me this 6th day of December, 19 72

Muriel F. C. Jeram  
Notary Public.

My commission expires \_\_\_\_\_

MURIEL F. C. JERAM  
NOTARY PUBLIC  
SEDGWICK COUNTY, KANSAS  
MY COMMISSION EXPIRES  
JULY 25, 1976

GABBERT-JONES, INC.  
WICHITA, KANSAS  
DRILLERS' WELL LOG

RECEIVED  
STATE CORPORATION COMMISSION  
DEC 7 - 1972  
12-7-72  
CONSERVATION DIVISION  
Wichita, Kansas

BROWN #1-7  
C NW NE, Section 7-32S-17W  
Comanche County, Kansas


Commenced: November 18, 1972  
Completed: December 2, 1972

OPERATOR: GRAHAM MICHAELIS CORP.

Depth		Formation	Remarks
From	To		
0	195	Sand	Ran 16 jts of new 24# 8 5/8" csg. set @ 678' cemented w/275 sks lite wt w/2% CC - 175 sks common 3% CC P.D. @ 3:45 PM 11/19/1972 Cement Circ. Centralizer @ 658' - 558' Basket @ 85'
195	1266	Redbed	
1266	1761	Shale-shells	
1761	2090	Shale	
2090	2317	Shale-lime	
2317	4464	Lime-shale	
4464	4525	Lime	
4525	4690	Lime-shale	
4690	5220	Lime	
5220	TD		

DRY AND ABANDONED


I, James S. Sutton, II, certify this is a correct copy of the Drillers' Log for the well drilled in the C NW NE, Section 7-32S-17W, Comanche County, Kansas, to the best of my knowledge and belief.

  
James S. Sutton, II

STATE OF KANSAS        )  
                              ) SS  
COUNTY OF SEDGWICK )

Before me, the undersigned, a Notary Public within and for said County and State, on this 5th day of December 1972, personally appeared James S. Sutton, II to me personally known to be the identical person who executed the within and foregoing instrument and acknowledged to me that he executed the same as his free and voluntary act and deed for the uses and purposes therein set forth.

IN WITNESS WHEREOF, I have hereunto set my hand and official seal the day and year last above written.

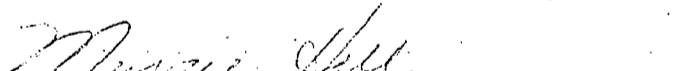  
Marjorie Hall, Notary Public

My commission expires Nov. 29, 1975

