

15-033-20197-0000

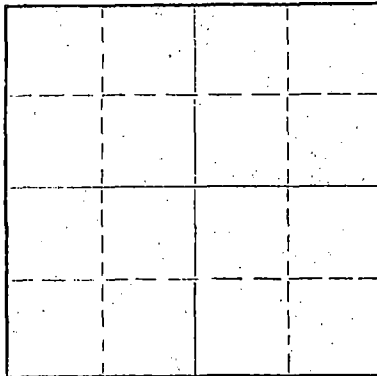
STATE OF KANSAS
STATE CORPORATION COMMISSION

Form CP-4

Give All Information Completely
Make Required Affidavit
Mail or Deliver Report to:
Conservation Division
State Corporation Commission
211 No. Broadway
Wichita, Kansas

WELL PLUGGING RECORD

NORTH

Locate well correctly on above
Section Plat

Commanche

County. Sec. 21 Twp. 31S Rge. 18W (E) (W)

Location as "NE/CNW&SW&" or footage from lines approx. 50' East of C SW NE

Lease Owner Lee Phillips Oil Company

Lease Name Herd

Well No. 1

Office Address Suite 1532, 125 N. Market, Wichita, Kansas 67202

Character of Well (completed as Oil, Gas or Dry Hole) Dry Hole

Date well completed 3-17 19 76

Application for plugging filed 3-17 19 76

Application for plugging approved 3-17 19 76

Plugging commenced 3-17 19 76

Plugging completed 3-17 19 76

Reason for abandonment of well or producing formation Dry Hole

If a producing well is abandoned, date of last production 19

Was permission obtained from the Conservation Division or its agents before plugging was commenced? yes

Name of Conservation Agent who supervised plugging of this well G. Russell Bieberstein

Producing formation Depth to top Bottom Total Depth of Well 5195 Feet

Show depth and thickness of all water, oil and gas formations.

OIL, GAS OR WATER RECORDS

CASING RECORD

FORMATION	CONTENT	FROM	TO	SIZE	PUT IN	PULLED OUT
				13"	366'	-

Describe in detail the manner in which the well was plugged, indicating where the mud fluid was placed and the method or methods used in introducing it into the hole. If cement or other plugs were used, state the character of same and depth placed, from feet to feet for each plug set.

Mud to 300', 50 sacks cement
 Mud to 40', plug, 1/2 sack hulls
 and 20 sacks cement
 5 sacks cement in rathole

RECEIVED
STATE CORPORATION COMMISSIONMAR 23 1978
3-23-76
CONSERVATION DIVISION
Wichita, Kansas

(If additional description is necessary, use BACK of this sheet)

Name of Plugging Contractor

Address

STATE OF KANSAS, COUNTY OF SEDGWICK, ss.
Don Gardner

(employee of owner) of the above-described well, being first duly sworn on oath, says: That I have knowledge of the facts, statements, and matters herein contained and the log of the above-described well as filed and that the same are true and correct. So help me God.

(Signature)

Suite 250, 200 W. Douglas, Wichita, Kansas 67202

(Address)

SUBSCRIBED AND SWORN TO before me this 22nd day of March, 19 76

My commission expires

March 1, 1978

Notary Public.

DRILLERS LOG

#1 HERD
approx. 50' East of
C SW NE Section 21-31S-18W
Commanche County, Kansas

OPERATOR: Lee Phillips Oil Company
Suite 1532, 125 N. Market
Wichita, Kansas 67202

CONTRACTOR: Dunne-Gardner Petroleum, Inc.
Suite 250, 200 West Douglas
Wichita, Kansas 67202

COMMENCED: March 3, 1976

COMPLETED: March 17, 1976

CASING RECORD: 13" @ 366' w/400 sx

FROM	TO	DESCRIPTION
0	368	Sand
368	750	Red bed
750	1505	Red bed and shale
1505	4105	Lime and shale
4105	4310	Lime
4310	4480	Lime and shale
4480	4565	Lime
4565	4642	Lime and shale
4642	4750	Lime
4750	4814	Lime and shale
4814	5195	Lime
5195		Rotary total depth

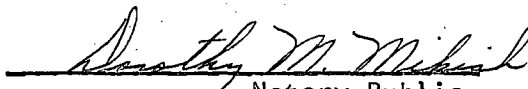
STATE OF KANSAS)
COUNTY OF SEDGWICK) ss

I hereby certify that the above is a true and correct log, to the best of my knowledge and belief.


Don Gardner

Subscribed and sworn to before me this 22nd day of March, 1976.

My commission expires:
March 1, 1978


Dorothy M. Michal
Notary Public

RECEIVED
MAR 23 1976
3-23-76
3000 EXHIBIT ON 3-23
Wichita, Kansas