


STATE OF KANSAS  
STATE CORPORATION COMMISSION

WELL PLUGGING RECORD

Give All Information Completely  
Make Required Affidavit  
Mail or Deliver Report to  
Conservation Division  
State Corporation Comm.  
245 North Water  
Wichita, KS 67202

Comanche County. Sec. 24 Twp. 32S Rge. 16W  
Location as "NE/CNW $\frac{1}{4}$ /SW $\frac{1}{4}$ " or footage from lines C W/2 NE

Lease Owner Hummon Corporation  
Lease Name Einsel Well No. 1-A  
Office Address 400 One Main Place, Wichita, Kansas  
Character of Well (Completed as Oil, Gas or Dry Hole) Dry Hole

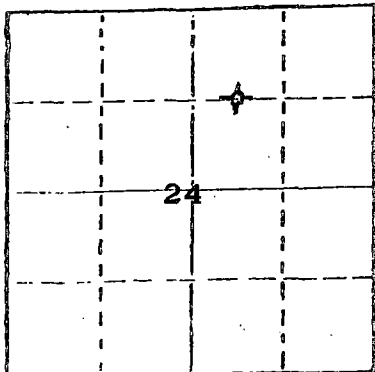

Locate well correctly on above  
Section Plat

Date Well completed March 18, 1980  
Application for plugging filed March 18, 1980  
Application for plugging approved March 18, 1980  
Plugging commenced March 18, 1980  
Plugging completed March 18, 1980  
Reason for abandonment of well or producing formation Dry Hole

If a producing well is abandoned, date of last production 19

Was permission obtained from the Conservation Division or its agents before plugging was commenced? Yes

Name of Conservation Agent who supervised plugging of this well Wm. T. Owen  
Producing formation \_\_\_\_\_ Depth to top \_\_\_\_\_ Bottom \_\_\_\_\_ Total Depth of Well 4832'  
Show depth and thickness of all water, oil and gas formations.

OIL, GAS OR WATER RECORDS

CASING RECORD

FORMATION	CONTENT	FROM	TO	SIZE	PUT IN	PULLED OUT
		0'	408'	8-5/8"	401.68'	None

Describe in detail the manner in which the well was plugged, indicating where the mud fluid was placed and the method or methods used in introducing it into the hold. If cement or other plugs were used, state the character of same and depth placed, from \_\_\_\_\_ feet to \_\_\_\_\_ feet for each plug set.

Plugged with 40 sacks cement and plug at 720',  
40 sacks cement and plug at 415', 10 sacks cement  
and plug at 40', and 5 sacks cement in rat hole.

(If additional description is necessary, use BACK of this sheet)

Name of Plugging Contractor Allied Cementing Co.

STATE OF KANSAS COUNTY OF SEDGWICK, ss.  
John D. Knightley Agent (employee of owner) or (owner or operator)  
of the above-described well, being first duly sworn on oath, says: That I have knowledge of the facts, statements, and matters herein contained and the log of the above-described well as filed and that the same are true and correct. So help me God.

(Signature) [Signature]  
221 S. Broadway, Wichita, Kansas 67202  
(Address)

SUBSCRIBED AND SWORN TO before me this 3rd day of April, 1980

[Signature]  
Notary Public.

My commission expires March 12, 1983

RECEIVED  
STATE CORPORATION COMMISSION  
4-8-80  
APR - 8 1980  
CONSERVATION DIVISION  
Wichita, Kansas

Hummon Corporation  
400 One Main Place  
Wichita, Kansas 67202

- Einsel #1-A  
C W/2 NE Sec. 24-32S-16W  
Comanche County, Kansas

Contractor: D. R. Lauck Oil Company, Inc.  
221 S. Broadway, Suite 400  
Wichita, Kansas 67202

Commenced: March 5, 1980  
Completed: March 18, 1980

Drillers Log

Gyp	41
Shale	410
Shale & Shells	1840
Shale & Lime	2010
Shale	3295
Lime & Shale	3660
Lime	4832 RTD

RECEIVED  
OIL CORPORATION COMMISSION

APR - 8 1980

CONSERVATION DIVISION  
Wichita, Kansas