

15-033-20166-00-00

STATE OF KANSAS  
STATE CORPORATION COMMISSION

Form CP-4

Give All Information Completely  
Make Required Affidavit  
Mail or Deliver Report to:  
Conservation Division  
State Corporation Commission

WELL PLUGGING RECORD

P. O. Box 17027  
Wichita, Kansas 67217  
NORTH

Comanche County, Sec 19 Twp 31S Rge. (E) 19 (W)

Location as "NE/CNW&SW" or footage from lines C SE NE

Lease Owner Cities Service Oil Company

Lease Name ELLIS Well No. #1

Office Address 209 E. William, Suite 700, Wichita, Ks. 67202

Character of Well (completed as Oil, Gas or Dry Hole) Dry Hole

Date well completed November 24 1974


Application for plugging filed (verbal) November 24 1974

Application for plugging approved (verbal) November 24 1974

Plugging commenced November 24 1974

Plugging completed November 24 1974

Reason for abandonment of well or producing formation Dry Hole

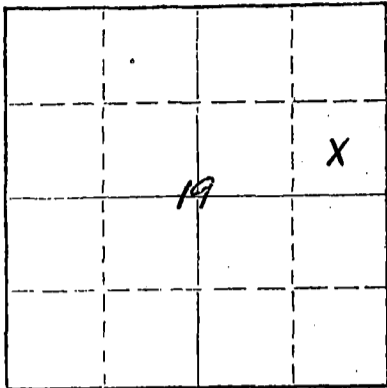

Locate well correctly on above  
Section Plat

If a producing well is abandoned, date of last production 19

Was permission obtained from the Conservation Division or its agents before plugging was commenced? Yes

Name of Conservation Agent who supervised plugging of this well Mr. G. Russell Biberstein

Producing formation Depth to top Bottom Total Depth of Well 6175 Feet

Show depth and thickness of all water, oil and gas formations.

OIL, GAS OR WATER RECORDS

CASING RECORD

FORMATION	CONTENT	FROM	TO	SIZE	PUT IN	PULLED OUT
				8-5/8"	480'	None

Describe in detail the manner in which the well was plugged, indicating where the mud fluid was placed and the method or methods used in introducing it into the hole. If cement or other plugs were used, state the character of same and depth placed, from feet to feet for each plug set.

1st Plug set @ 400' with 45 sacks Cement

2nd Plug set @ 40' with 20 sacks Cement

Rat Hole plugged with 2 sacks Cement

RECEIVED  
STATE CORPORATION COMMISSION

NOV 27 1974

CONSERVATION DIVISION  
Wichita, Kansas

11-27-1974

(If additional description is necessary, use BACK of this sheet)  
Name of Plugging Contractor Abercrombie Drilling, Inc.  
Address 801 Union Center, Wichita, Kansas 67202

STATE OF KANSAS, COUNTY OF SEDGWICK, ss.  
Jack K. Wharton, Geologist (employee of owner) or (owner or operator) of the above-described


well, being first duly sworn on oath, says: That I have knowledge of the facts, statements, and matters herein contained and the log of the above-described well as filed and that the same are true and correct. So help me God.

(Signature) Jack K. Wharton  
Jack K. Wharton 801 Union Center, Wichita, Ks.

(Address)

26th day of November, 1974

Nancy E. Bledsoe  
Nancy E. Bledsoe Notary Public.

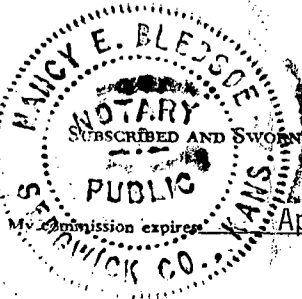

CONTRACTOR'S WELL LOG

15-033-20166-00-00

OPERATOR: Cities Service Oil Company  
 CONTRACTOR: Abercrombie Drilling, Inc.  
 WELL NAME: ELLIS #1  
 LOCATION: C SE NE Section 19-31S-19W  
 Comanche County, Kansas  
 SPUD DATE: October 29, 1974  
 COMPLETION DATE: November 24, 1974

0	210	Sand
210	1000	Red Bed & Shale
1000	2378	Shale
2378	2745	Shale & Lime
2745	3060	Lime & Shale
3060	3274	Lime
3274	4135	Lime & Shale
4135	4435	Lime
4435	4768	Lime & Shale
4768	4811	Lime with Shale & Chert
4811	5107	Lime & Chert
5107	5180	Lime
5180	5220	Lime & Chert
5220	6016	Lime
6016	6175	Lime & Sand
	6175	Rotary Total Depth

RECEIVED  
 STATE CORPORATION COMMISSION  
 NOV 27 1974  
 11-27-1974  
 CONSERVATION DIVISION  
 Wichita, Kansas

Drilled 482' of 12 1/4" surface hole. Ran 12 jts., new 8-5/8" surface casing. Set @480'. Cemented with 250 sacks Halco Light, 2% ca.cl. and 100 sacks Common, 3% ca.cl. Plug was down @ 6:05 a.m., October 30, 1974.  
 D & A: 1st Plug set @ 400' with 45 sacks cement, 2nd Plug set @ 40' with 20 sacks cement, Plugged rat hole with 2 sacks cement. Plug was down @3:30 p.m., November 24, 1974, State Plugger: G. Russell Biberstein.

STATE OF KANSAS )  
 ) SS  
 COUNTY OF SEDGWICK )

Mr. Jack K. Wharton, Geologist of Abercrombie Drilling, Inc. does hereby state that the above and foregoing is a true and correct copy of the log of the ELLIS #1, C SE NE, Section 19-31S-19W, Comanche County, Kansas.

ABERCROMBIE DRILLING, INC.

By: Jack K. Wharton  
 Jack K. Wharton, Geologist

Subscribed and sworn to before me, a Notary Public, in and for the aforesaid county and state as of this 26th day of November, 1974.

Nancy E. Bledsoe  
 Nancy E. Bledsoe, Notary Public

My Commission Expires: April 8, 1978

