

CARD MUST BE TYPED

State of Kansas
NOTICE OF INTENTION TO DRILL

CARD MUST BE SIGNED

(see rules on reverse side)

Starting Date: July 15 1984
month day year

API Number 15- 033-20,655-00-00

OPERATOR: License # 5171

SE... SE... See 31 Twp 32 S, Rge 16... East
(location) West

Name TXO Production Corp.

Address 200 West Douglas, Suite 300

City/State/Zip Wichita, KS 67202

Contact Person Jerry Collins

Phone 316-265-9441

CONTRACTOR: License # 5106

Name Freeman Drilling, Inc.

City/State 251 N. Water, Suite 10, Wichita, KS67202

660 Ft North from Southeast Corner of Section

660 Ft West from Southeast Corner of Section

(Note: Locate well on Section Plat on reverse side)

Nearest lease or unit boundary line 660 feet.

County Comanche

Lease Name McANINCH-GREGG Well# 4

Domestic well within 330 feet: yes no

Municipal well within one mile: yes no

Well Drilled For: Well Class: Type Equipment:

Oil Swd Infield Mud Rotary

Gas Inj Pool Ext. Air Rotary

OWWO Expl Wildcat Cable

If OWWO: old well info as follows:

Operator

Well Name

Comp Date Old Total Depth

Projected Total Depth 5150 feet

Projected Formation at TD Miss

Expected Producing Formations Miss

Depth to Bottom of fresh water 100 feet

Lowest usable water formation Unknown

Depth to Bottom of usable water 200 feet

Surface pipe by Alternate: 1 2

Surface pipe to be set 400 feet

Conductor pipe if any required 0 feet

Ground surface elevation TBD feet MSL

This Authorization Expires 1/5/85

Approved By 7/5/84

I certify that we will comply with K.S.A. 55-101, et seq., plus eventually plugging hole to K.C.C. specifications.

Date 7-3-84 Signature of Operator or Agent

Jerry W. Collins


Title Drlg & Completion Engr.

MHC/KOHE 7-5-84

Must be filed with the K.C.C. five (5) days prior to commencing well
This card void if drilling not started within six (6) months of date received by K.C.C.

Important procedures to follow :

**A Regular Section of Land
1 Mile = 5,280 Ft.**

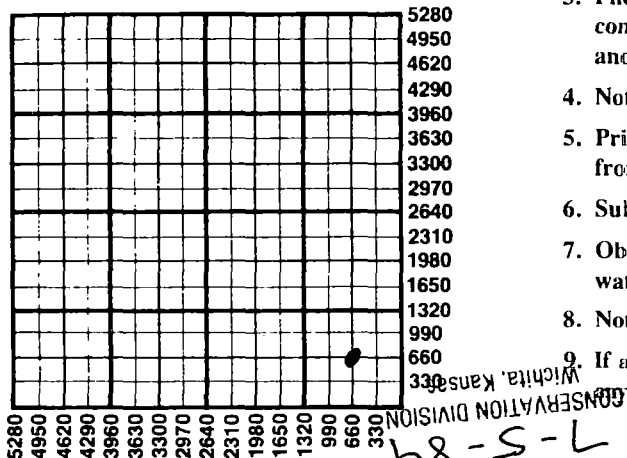

1. Notify District office before setting surface casing.
2. Set surface casing by circulating cement to the top.
3. File completion forms ACO-1 with K.C.C. within 90 days of well completion, following instructions on ACO-1, side 1, and including copies of wireline logs.
4. Notify District office 48 hours prior to old well workover or re-entry.
5. Prior to plugging, prepare a plugging plan, then obtain agreement from the appropriate district office for an approved plugging plan.
6. Submit plugging report (CP-4) to K.C.C. after plugging is completed.
7. Obtain an approved injection docket number before disposing of salt water.
8. Notify K.C.C. within 10 days when injection commences or terminates.
9. If an alternate 2 completion, cement in the production pipe from below usable water to surface within 120 days of spud date.

State Corporation Commission of Kansas
Conservation Division
200 Colorado Derby Building
Wichita, Kansas 67202
(316) 263-3238

RECEIVED
STATE CORPORATION COMMISSION