

Must be approved by the K.C.C. five (5) days prior to commencing well

Expected Spud Date 12 20 91 AM NE NE NE Sec 13 Twp 31 S, Rg 19 X East
month day year 4770

OPERATOR: License # 6006
Name: Molz Oil Company
Address: R.R. #2, Box 54
City/State/Zip: Kiowa, Kansas 67070
Contact Person: Jim Molz
Phone: 316-296-4558

CONTRACTOR: License #: 5418
Name: Allen Drilling

Well Drilled For: Well Class: Type Equipment:
 Oil ... Inj ... Infield Mud Rotary
 Gas ... Storage ... Pool Ext. ... Air Rotary
... OWWO ... Disposal Wildcat ... Cable
... Seismic; 1 # of Holes

If OWWO: old well information as follows:
Operator:
Well Name:
Comp. Date: Old Total Depth

Directional, Deviated or Horizontal wellbore? yes no
If yes, total depth location:

..... feet from South line of Section
..... 375 feet from East line of Section
(Note: Locate well on Section Plat on Reverse Side)

County: Comanche
Lease Name: Pauline Well #: 1
Field Name: Alford Southeast Unnamed
Is this a Prorated Field? yes no
Target Formation(s): Mississippi
Nearest lease or unit boundary: 375
Ground Surface Elevation: 2165 GR feet MSL
Domestic well within 330 feet: yes no
Municipal well within one mile: yes no
Depth to bottom of fresh water: 250
Depth to bottom of usable water: 250
Surface Pipe by Alternate: 1 2
Length of Surface Pipe Planned to be set: 400
Length of Conductor pipe required: NONE
Projected Total Depth: 5400
Formation at Total Depth: Mississippi
Water Source for Drilling Operations:
 well farm pond other
DWR Permit #:
Will Cores Be Taken?: yes no
If yes, proposed zone:

AFFIDAVIT

The undersigned hereby affirms that the drilling, completion and eventual plugging of this well will comply with K.S.A. 55-101, et. seq.

It is agreed that the following minimum requirements will be met:

1. The appropriate district office shall be notified before setting surface pipe;
2. The minimum amount of surface pipe as specified above shall be set by circulating cement to the top; in all cases surface pipe shall be set through all unconsolidated materials plus a minimum of 20 feet into the underlying formation;
3. If the well is dry, a plugging proposal shall be submitted to the district office. An agreement between the operator and the district office on plug length and placement is necessary prior to plugging;
4. The appropriate district office will be notified before well is either plugged or production casing is cemented in;
5. If an Alternate II completion, production pipe shall be cemented from below any usable water to surface within 120 days of spud date. In all cases, notify district office prior to any cementing.

I hereby certify that the statements made herein are true and to the best of my knowledge and belief.

Date: 1-2-91 Signature of Operator or Agent: [Signature] Title: [Signature]

FOR KCC USE:
API # 15- 033-20806-00-00
Conductor pipe required None feet
Minimum surface pipe required 270 feet per Alt. OK
Approved by: DA 1-7-91
EFFECTIVE DATE: 1-12-91
This authorization expires: 7-7-91
(This authorization void if drilling not started within 6 months of effective date.)
Spud date: _____ Agent: _____

RECEIVED
STATE COMMISSION
01-04-1991
DIVISION

13
31
19

REMEMBER TO:

- File Drill Pit Application (form CDP-1) with Intent to Drill;
- File Completion Form ACO-1 within 120 days of spud date;
- File acreage attribution plat according to field proration orders;
- Notify appropriate district office 48 hours prior to workover or re-entry;
- Submit plugging report (CP-4) after plugging is completed;
- Obtain written approval before disposing or injecting salt water.


PLAT OF ACREAGE ATTRIBUTABLE TO A WELL

State Corporation Commission, Conservation Division
200 Colorado Derby Bldg. Wichita, Kansas 67202

OPERATOR Molz Oil Company #6006 LOCATION OF WELL:
LEASE Pauline 2130 feet north of SE corner
WELL NUMBER #1 375 feet west of SE corner
FIELD Alford Southwest NE Sec. 13 T 31s R 19 1/4 W
COUNTY Commanche
NO. OF ACRES ATTRIBUTABLE TO WELL 160 IS SECTION X REGULAR IRREGULAR?
DESCRIPTION OF ACREAGE NE IF IRREGULAR, LOCATE WELL FROM NEAREST
CORNER BOUNDARY.

NOTE: If plat depicted is insufficient for your circumstances, you may attach your own scaled or surveyed plat.

PLAT

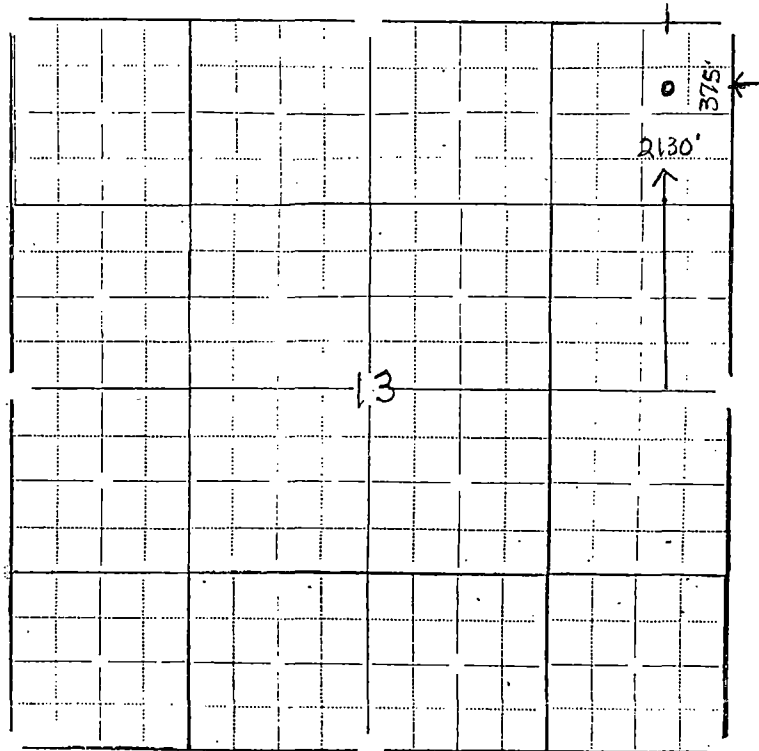

In plotting the proposed location of the well, you must show:

- 1) The manner in which you are using the depicted plat by identifying section lines, i.e. 1 section, 1 section with 8 surrounding partial sections, 4 sections, 16 sections, etc.;
- 2) the well's location relative to the location of other wells producing from the same common source of supply in adjoining drilling units, pursuant to K.A.R. 82-3-108, 82-3-207, 82-3-312, or special orders of the Commission;
- 3) the distance of the proposed drilling location from the section's east and south lines; and
- 4) the distance to the nearest lease or unit boundary line.

I hereby certify that the statements made herein are true and to the best of my knowledge and belief.

Signature of Operator or Agent [Signature]

Date 1-3-91 Title President