

FOR KCC USE:

"TIGHT HOLE "

FORM C-1 7/91

FORM MUST BE TYPED

FORM MUST BE SIGNED

ALL BLANKS MUST BE FILLED

EFFECTIVE DATE: 9-13-99

State of Kansas

DISTRICT # 1

NOTICE OF INTENTION TO DRILL

SGA? Yes No

Must be approved by the K.C.C. five (5) days prior to commencing well.

Expected Spud Date 9 -- 10 -- 99 month day year

Spot 240' So of Sec 17 Twp 31 S, Rg 19 East

OPERATOR: License # 30407 Name: Black Petroleum Company Address: P.O. Box 12922 City/State/Zip: Wichita, Kansas 67277-2922 Contact Person: Thomas E. Black Phone: 316-729-8220

420 feet from South/North line of Section 660 feet from East/West line of Section IS SECTION X REGULAR IRREGULAR?

CONTRACTOR: License #: 5123 Name: Pickrell Drilling Company, Inc.

(NOTE: Locate well on the Section Plat on Reverse Side) County: Comanche

Well Drilled For: Well Class: Type Equipment:

- X Oil ... Enh Rec ... Infield X Mud Rotary X Gas ... Storage ... Pool Ext. ... Air Rotary ... OWWO ... Disposal X Wildcat ... Cable ... Seismic; ... # of Holes ... Other

Lease Name: Swayze Twin Well #: #1 Field Name: Wildcat

If OWWO: old well information as follows: Operator: Well Name: Comp. Date: Old Total Depth

Is this a Prorated/Spaced Field? yes X no Target Formation(s): Mississippi

Directional, Deviated or Horizontal wellbore? yes X no If yes, true vertical depth: Bottom Hole Location:

Ground Surface Elevation: 2170 feet MSL Water well within one-quarter mile: yes X no

Public water supply well within one mile: yes X no Depth to bottom of fresh water: 200'

Depth to bottom of usable water: 280' Surface Pipe by Alternate: X 1 650'

Length of Surface Pipe Planned to be set: Non Required Length of Conductor pipe required: 5250'

Projected Total Depth: 5250' Formation at Total Depth: Mississippi

Water Source for Drilling Operations: well farm pond X other

Will Cores Be Taken? yes X no If yes, proposed zone:

\*RIG WAS SKID FROM THE SWAYZE #1.

AFFIDAVIT

The undersigned hereby affirms that the drilling, completion and eventual plugging of this well will comply with K.S.A. 55-101, et. seq. It is agreed that the following minimum requirements will be met:

- 1. Notify the appropriate district office prior to spudding of well; 2. A copy of the approved notice of intent to drill shall be posted on each drilling rig; 3. The minimum amount of surface pipe as specified below shall be set by circulating cement to the top; in all cases surface pipe shall be set through all unconsolidated materials plus a minimum of 20 feet into the underlying formation; 4. If the well is dry hole, an agreement between the operator and the district office on plug length and placement is necessary prior to plugging; 5. The appropriate district office will be notified before well is either plugged or production casing is cemented in; 6. IF AN ALTERNATE II COMPLETION, PRODUCTION PIPE SHALL BE CEMENTED FROM BELOW ANY USABLE WATER TO SURFACE WITHIN 120 DAYS OF SPUD DATE. IN ALL CASES, NOTIFY DISTRICT OFFICE PRIOR TO ANY CEMENTING.

I hereby certify that the statements made herein are true and to the best of my knowledge and belief.

Date: 9-09-99 Signature of Operator or Agent: [Signature] Title: Agent

FOR KCC USE: API # 15- 033-21032-0000 Conductor pipe required NONE feet Minimum surface pipe required 300 feet per Alt. (1) 2 Approved by: JK 9-8-99 This authorization expires: 3-8-2000 (This authorization void if drilling not started within 6 months of effective date.) Spud date: Agent:

Rec'd 09-08-1999

17 31 1923

REMEMBER TO:

- File Drill Pit Application (form CDP-1) with Intent to Drill; - File Completion Form ACO-1 within 120 days of spud date; - File acreage attribution plat according to field proration orders; - Notify appropriate district office 48 hours prior to workover or re-entry; - Submit plugging report (CP-4) after plugging is completed; - Obtain written approval before disposing or injecting salt water.

Mail to: KCC - Conservation Division, 130 S. Market - Room 2078, Wichita, Kansas 67202.

**IN ALL CASES PLOT THE INTENDED WELL ON THE PLAT BELOW**

**PLAT OF ACREAGE ATTRIBUTABLE TO A WELL IN A PRORATED OR SPACED FIELD**

If the intended well is in a prorated or spaced field, please fully complete this side of the form. If the intended well is in a prorated or spaced field complete the plat below showing that the well will be properly located in relationship to other wells producing from the common source of supply. Please show all the wells within 1 mile of the boundaries of the proposed acreage attribution unit for gas wells and within 1/2 mile of the boundaries of the proposed acreage attribution unit for oil wells.


API NO. 15- \_\_\_\_\_  
 OPERATOR Black Petroleum LOCATION OF WELL: COUNTY Comanche  
 LEASE #1 Swayze "Twin" 420 feet from south/north line of section  
 WELL NUMBER 1 660 feet from east/west line of section  
 FIELD Wildcat SECTION 17 TWP 31S RG 19W

NUMBER OF ACRES ATTRIBUTABLE TO WELL \_\_\_\_\_ IS SECTION X REGULAR or \_\_\_\_\_ IRREGULAR  
 QTR/QTR/QTR OF ACREAGE C - SE - SE **IF SECTION IS IRREGULAR, LOCATE WELL FROM NEAREST CORNER BOUNDARY.**


Section corner used: \_\_\_\_\_ NE \_\_\_\_\_ NW X SE \_\_\_\_\_ SW

**PLAT**

(Show location of the well and shade attributable acreage for prorated or spaced wells.)  
 (Show footage to the nearest lease or unit boundary line.)

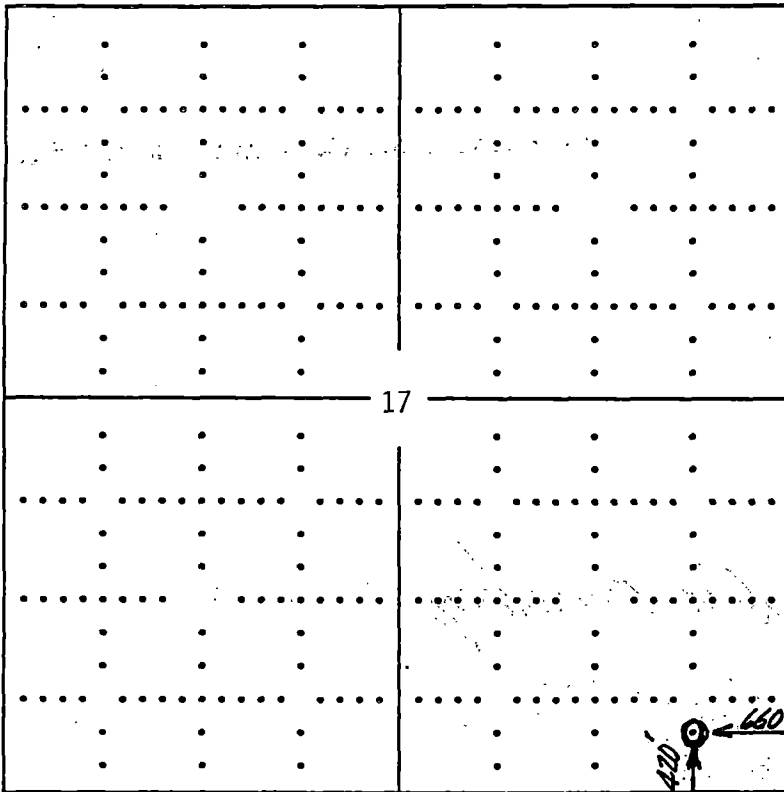

ONE SECTION

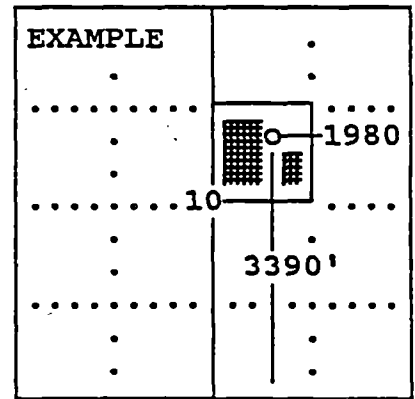

SEWARD CO.

**In plotting the proposed location of the well, you must show:**

- 1) The manner in which you are using the depicted plat by identifying section lines, i.e. 1 section, 1 section with 8 surrounding sections, 4 sections, etc.;
- 2) the distance of the proposed drilling location from the section's south/north and east/west; and
- 3) the distance to the nearest lease or unit boundary line.