

FOR KCC USE:

EFFECTIVE DATE: 4-21-02

DISTRICT #

SEAL:  Yes  No

*First*  
**CORRECTED**

State of Kansas

NOTICE OF INTENTION TO DRILL

Must be approved by the K.C.C. five (5) days prior to commencing work

RECEIVED

APR 16 2002

4-16-02  
KCC WICHITA

FORM C-1 7/91

FORM MUST BE TYPED

FORM MUST BE SIGNED

ALL BLANKS MUST BE FILLED

Expected Spud Date May 15, 2002 *X* AP 34'E SE-SW NW Sec 3 Twp 32 S, Rg 19  East  West

OPERATOR: License # 6528  
Name: R. J. Patrick Operating Company  
Address: P O Box 1157  
City/State/Zip: Liberal, Kansas 67905-1157  
Contact Person: R. J. Patrick  
Phone: (620) 624-8483

CONTRACTOR: License # 5929  
Name: DUKE DRILLING COMPANY, INC.

Well Drilled For: Well Class: Type Equipment:  
 Oil ... Enh Rec ... Infield  Mud Rotary  
 Gas ... Storage ... Pool Ext. ... Air Rotary  
... OWD ... Disposal  Wildcat ... Cable  
... Seismic; ... # of Holes ... Other  
If OWD: old well information as follows:  
Operator: .....  
Well Name: .....  
Comp. Date: ..... Old Total Depth .....

Directional, Deviated or Horizontal wellbore? .... yes  no  
If yes, true vertical depth: .....  
Bottom Hole Location: .....

2310' ..... feet from ~~South~~ North line of Section 1024  
1024' ..... feet from ~~East~~ West line of Section  
IS SECTION  REGULAR  IRREGULAR?  
(NOTE: Locate well on the Section Plat on Reverse Side)  
County: Comanche  
Lease Name: INEZ BEAN Well #: 3-3  
Field Name: WILDCAT  
Is this a Prorated/Spaced Field? yes  no  
Target Formation(s): MISSISSIPPIAN  
Nearest lease or unit boundary: 338  
Ground Surface Elevation: 2102 feet MSL  
Water well within one-quarter mile: .... yes  no  
Public water supply well within one mile: .... yes  no  
Depth to bottom of fresh water: 100'  
Depth to bottom of usable water: 240'  
Surface Pipe by Alternate:  1  2  
Length of Surface Pipe Planned to be set: 650  
Length of Conductor pipe required: AS NEEDED  
Projected Total Depth: 5500'  
Formation at Total Depth: MISSISSIPPIAN  
Water Source for Drilling Operations:  
 well  farm pond  other  
DWR Permit #: Apply for  
Will Cores Be Taken? .... yes  no  
If yes, proposed zone: .....

**AFFIDAVIT**

*X* WAS 34' W of SW-SW-NW

*X* IS 34'E of SE-SW-NW

The undersigned hereby affirms that the drilling, completion and eventual plugging of this well will comply with K.S.A. 55-101, et. seq.  
It is agreed that the following minimum requirements will be met:

1. Notify the appropriate district office prior to spudding of well;
2. A copy of the approved notice of intent to drill shall be posted on each drilling rig;
3. The minimum amount of surface pipe as specified below shall be set by circulating cement to the top; in all cases surface pipe shall be set through all unconsolidated materials plus a minimum of 20 feet into the underlying formation;
4. If the well is dry hole, an agreement between the operator and the district office on plug length and placement is necessary prior to plugging;
5. The appropriate district office will be notified before well is either plugged or production casing is cemented in;
6. IF AN ALTERNATE II COMPLETION, PRODUCTION PIPE SHALL BE CEMENTED FROM BELOW ANY USABLE WATER TO SURFACE WITHIN 120 DAYS OF SPUD DATE. IN ALL CASES, NOTIFY DISTRICT OFFICE PRIOR TO ANY CEMENTING.

I hereby certify that the statements made herein are true and to the best of my knowledge and belief.

Date: APRIL 12, 2002 Signature of Operator or Agent: R. J. Patrick Title: OWNER

FOR KCC USE:  
API # 15- 033-21310-0000  
Conductor pipe required NONE feet  
Minimum surface pipe required 260 feet per Alt. (1)   
Approved by: RSP 4-16-2002/4-17-2002  
This authorization expires: 10-16-2002  
(This authorization void if drilling not started within 6 months of effective date.)  
Spud date: \_\_\_\_\_ Agent: \_\_\_\_\_

**REMEMBER TO:**

- File Drill Pit Application (form CDP-1) with Intent to Drill;
- File Completion Form ACO-1 within 120 days of spud date;
- File acreage attribution plat according to field proration orders;
- Notify appropriate district office 48 hours prior to workover or re-entry;
- Submit plugging report (CP-4) after plugging is completed;
- Obtain written approval before disposing or injecting salt water.

Mail to: Conservation Division, 200 Colorado Darby Building, 202 W. First St., Wichita, Kansas 67202-1286.

W  
32  
19W

IN ALL CASES PLOT THE INTENDED WELL ON THE PLAT BELOW.

PLAT OF ACREAGE ATTRIBUTABLE TO A WELL IN A PRORATED OR SPACED FIELD

If the intended well is in a prorated or spaced field, please fully complete this side of the form. If the intended well is in a prorated or spaced field complete the plat below showing that the well will be properly located in relationship to other wells producing from the common source of supply. Please show all the wells within 1 mile of the boundaries of the proposed acreage attribution unit for gas wells and within 1/2 mile of the boundaries of the proposed acreage attribution unit for oil wells.

API NO. 15- \_\_\_\_\_  
 OPERATOR \_\_\_\_\_  
 LEASE \_\_\_\_\_  
 WELL NUMBER \_\_\_\_\_  
 FIELD \_\_\_\_\_

LOCATION OF WELL: COUNTY \_\_\_\_\_  
 \_\_\_\_\_ feet from south/north line of section  
 \_\_\_\_\_ feet from east/west line of section  
 SECTION \_\_\_\_\_ TWP \_\_\_\_\_ RG \_\_\_\_\_



NUMBER OF ACRES ATTRIBUTABLE TO WELL \_\_\_\_\_  
 QTR/QTR/QTR OF ACREAGE \_\_\_\_\_ - \_\_\_\_\_ - \_\_\_\_\_

IS SECTION \_\_\_\_\_ REGULAR or \_\_\_\_\_ IRREGULAR  
IF SECTION IS IRREGULAR, LOCATE WELL FROM NEAREST CORNER BOUNDARY.

Section corner used: \_\_\_\_\_ NE \_\_\_\_\_ NW \_\_\_\_\_ SE \_\_\_\_\_ SW

PLAT

(Show location of the well and shade attributable acreage for prorated or spaced wells.)  
 (Show footage to the nearest lease or unit boundary line.)

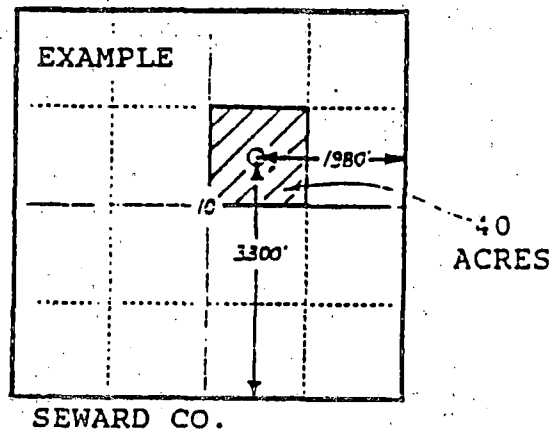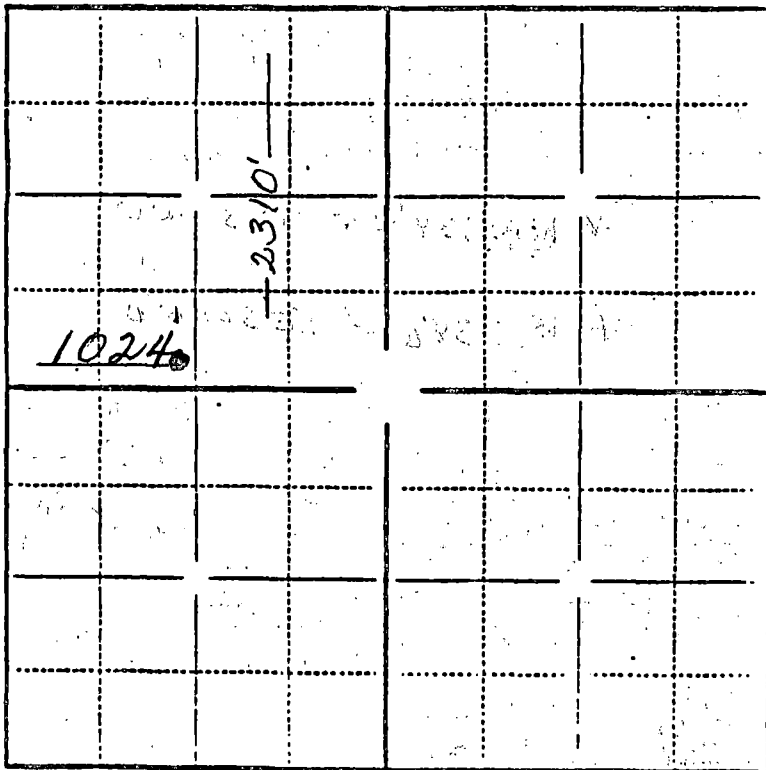

In plotting the proposed location of the well, you must show:

- 1) The manner in which you are using the depicted plat by identifying section lines, i.e. 1 section, 1 section with 8 surrounding sections, 4 sections, etc.;
- 2) the distance of the proposed drilling location from the section's south/north and east/west lines; and
- 3) the distance to the nearest lease or unit boundary line.