

CARD MUST BE TYPED

State of Kansas

CARD MUST BE SIGNED

NOTICE OF INTENTION TO DRILL

(see rules on reverse side)

Starting Date 10 21 86
month day year

API Number 15— 033-20,701-0000

OPERATOR: License # 3068

C... NE.. NE Sec... 30 Twp. 32.. S, Rg. 19.... East
 West

Name Hazelwood Production & Exploration Company

4620 Ft. from South Line of Section

Address 6801 N. Broadway, Suite 320

660 Ft. from East Line of Section

City/State/Zip Oklahoma City, Oklahoma 73116

(Note: Locate well on Section Plat on reverse side)

Contact Person Jim Hazelwood, Jr.

Nearest lease or unit boundary line 660 feet

Phone 405/848-6884

County Comanche

CONTRACTOR: License # 5840

Lease Name Reynolds Well # L

Name Brandt Drilling Company, Inc.

Ground surface elevation feet MSL

City/State Wichita, Kansas 67202

Domestic well within 330 feet: yes no

Well Drilled For:

Well Class:

Type Equipment:

Municipal well within one mile: yes no Oil SWD Infield Mud Rotary

Depth to bottom of fresh water 100

 Gas Inj Pool Ext. Air Rotary

Depth to bottom of usable water 200

 OWWO Expl Wildcat CableSurface pipe by Alternate: 500 1 2

If OWWO: old well info as follows:

Operator

Surface pipe planned to be set 3300 40

Well Name

Conductor pipe required 3300 40

Comp Date Old Total Depth

Projected Total Depth feet

I certify that well will comply with K.S.A. 55-101, et seq., plus eventually plugging hole to KCC specifications.

Date 10/15/86

Signature of Operator or Agent

Title Agent

For KCC Use:

Conductor Pipe Required feet; Minimum Surface Pipe Required 220 feet per Alt.

This Authorization Expires 4-16-87

Approved By 10-16-86

[Handwritten Signature]


[Handwritten Signature]

Must be filed with the K.C.C. five (5) days prior to commencing well
This card void if drilling not started within six (6) months of date received by K.C.C.

Important procedures to follow:

1. Notify District office before setting surface casing.
2. Set surface casing by circulating cement to the top.
3. File completion forms ACO-1 with K.C.C. within 90 days of well completion, following instructions on ACO-1, side 1, and including copies of wireline logs.
4. Notify District office 48 hours prior to old well workover or re-entry.
5. Prior to filing Intent, prepare a proposed plugging plan in case well is D & A, then obtain approval of plan when calling district office prior to setting surface pipe.
6. Submit plugging report (CP-4) to K. C. C. after plugging is completed.
7. Obtain an approved injection docket number before disposing of salt water.
8. Notify K.C.C. within 10 days when injection commences or terminates.
9. If an alternate 2 completion, cement in the production pipe from below any usable water to surface within 120 days of spud date.

**A Regular Section of Land
1 Mile = 5,280 Ft.**

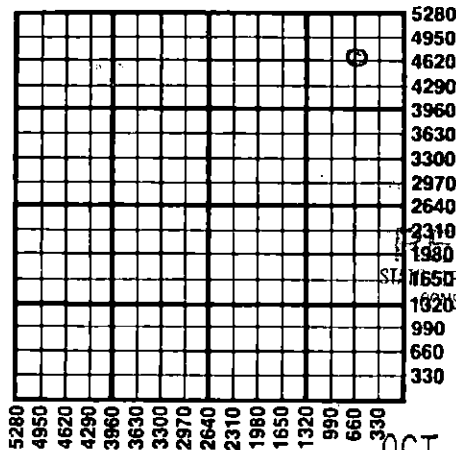

RECEIVED
STATE CORPORATION COMMISSION
WICHITA, DIV. WICHITA, KS

OCT 1 6 1986
10-16-86

State Corporation Commission of Kansas
Conservation Division
200 Colorado Derby Building
Wichita, Kansas 67202
(316) 263-3238