

EFFECTIVE DATE: 10-13-97

State of Kansas

DISTRICT # 1  
7. X Yes... No

NOTICE OF INTENTION TO DRILL

Must be approved by the K.C.C. five (5) days prior to commencing well.

Expected Spud Date 11 15 97  
month day year

Spot SW - SW - SE Sec 34 Twp 32 S, Rg 19 East West

OPERATOR: License # 3882  
Name: Samuel Gary, Jr. & Associates  
Address: 1670 Broadway, Suite 3300  
City/State/Zip: Denver, CO 80202  
Contact Person: Tom Bertal  
Phone: 303-831-4673

330 feet from South / North line of Section  
2310 feet from East / West line of Section

IS SECTION X REGULAR IRREGULAR?  
(NOTE: Locate well on the Section Plat on Reverse Side)

CONTRACTOR: License #: 5929  
Name: Duke Drilling Company

County: Comanche  
Lease Name: Brass Well #: 34-15  
Field Name: Colter west

\* Is this a Prorated/Spaced Field? ... yes X no

Well Drilled For: Well Class: Type Equipment:  
X. Oil ... Enh Rec ... Infield X. Mud Rotary  
... Gas ... Storage X. Pool Ext. ... Air Rotary  
... OWWO ... Disposal ... Wildcat ... Cable  
... Seismic; ... # of Holes ... Other

Target Formation(s): Arbuckle

Nearest lease or unit boundary: 330'

Ground Surface Elevation: 1932 feet MSL

Water well within one-quarter mile: ... yes X no

Public water supply well within one mile: ... yes X no

Depth to bottom of fresh water: 105'

Depth to bottom of usable water: 180'

Surface Pipe by Alternate: X. 1 2

Length of Surface Pipe Planned to be set: 650'

Length of Conductor pipe required: 60'

Projected Total Depth: 6400'

Formation at Total Depth: Arbuckle

Water Source for Drilling Operations:  
... well ... farm pond X ... other

If OWWO: old well information as follows:  
Operator: NA  
Well Name:  
Comp. Date: Old Total Depth

Directional, Deviated or Horizontal wellbore? ... yes X no  
If yes, true vertical depth:  
Hole Location:

Will Cores Be Taken?: ... yes X no  
If yes, proposed zone:

AFFIDAVIT

\* 80 ACRE SPACING FOR MISSISSIPPI FORMATION. WELL LOCATED IN THE CENTER OF ONE OF THE QTR QTR SECTIONS COMPRISING THE 80 ACRE UNIT.

The undersigned hereby affirms that the drilling, completion and eventual plugging of this well will comply with K.S.A. 55-101, et. seq.  
It is agreed that the following minimum requirements will be met:

- 1. Notify the appropriate district office prior to spudding of well;
- 2. A copy of the approved notice of intent to drill shall be posted on each drilling rig;
- 3. The minimum amount of surface pipe as specified below shall be set by circulating cement to the top; in all cases surface pipe shall be set through all unconsolidated materials plus a minimum of 20 feet into the underlying formation;
- 4. If the well is dry hole, an agreement between the operator and the district office on plug length and placement is necessary prior to plugging;
- 5. The appropriate district office will be notified before well is either plugged or production casing is cemented in;
- 6. IF AN ALTERNATE II COMPLETION, PRODUCTION PIPE SHALL BE CEMENTED FROM BELOW ANY USABLE WATER TO SURFACE WITHIN 120 DAYS OF SPUD DATE. IN ALL CASES, NOTIFY DISTRICT OFFICE PRIOR TO ANY CEMENTING.

I hereby certify that the statements made herein are true and to the best of my knowledge and belief.

Date: Sept. 29, 1997 Signature of Operator or Agent: Thomas Bertal Title: Geologist

FOR KCC USE:  
API # 15- 033-209430000  
Conductor pipe required NONE feet  
Minimum surface pipe required 200' feet per Alt. (1) X  
Approved by: JK 10-8-97  
This authorization expires: 4-8-98  
(This authorization void if drilling not started within 6 months of effective date.)  
Spud date: Agent:

\* LOST CIRCULATION  
CAN OCCUR AROUND  
420' +

RECEIVED  
KANSAS CORP COMM  
1997 OCT -1 A 11:43  
10-1-97  
34  
37  
1925

- REMEMBER TO:
- File Drill Pit Application (form CDP-1) with Intent to Drill;
  - File Completion Form ACO-1 within 120 days of spud date;
  - File acreage attribution plat according to field proration orders;
  - Notify appropriate district office 48 hours prior to workover or re-entry;
  - Submit plugging report (CP-4) after plugging is completed;
  - Obtain written approval before disposing or injecting salt water.

**IN ALL CASES NOT THE INTENDED WELL ON THIS PLAT BELOW**

**PLAT OF ACREAGE ATTRIBUTABLE TO A WELL IN A PRORATED OR SPACED FIELD**

the intended well is in a prorated or spaced field, please fully complete this side of the form. If the intended well is in a prorated or spaced field complete the plat below showing that the well will be properly located in relationship to other wells producing from the common source of supply. Please show all the wells within 1 mile of the boundaries of the proposed acreage attribution unit for gas wells and within 1/2 mile of the boundaries of the proposed acreage attribution unit for oil wells:



API NO. 15- \_\_\_\_\_  
 OPERATOR \_\_\_\_\_ LOCATION OF WELL: COUNTY \_\_\_\_\_  
 LEASE \_\_\_\_\_ feet from south/north line of section  
 WELL NUMBER \_\_\_\_\_ feet from east/west line of section  
 FIELD \_\_\_\_\_ SECTION \_\_\_\_\_ TWP \_\_\_\_\_ RG \_\_\_\_\_

NUMBER OF ACRES ATTRIBUTABLE TO WELL \_\_\_\_\_ IS SECTION \_\_\_\_\_ REGULAR or \_\_\_\_\_ IRREGULAR  
 QTR/QTR/QTR OF ACREAGE \_\_\_\_\_ IF SECTION IS IRREGULAR, LOCATE WELL FROM NEAREST  
 CORNER BOUNDARY.

Section corner used: \_\_\_\_\_ NE \_\_\_\_\_ NW \_\_\_\_\_ SE \_\_\_\_\_ SW

**PLAT**

(Show location of the well and shade attributable acreage for prorated or spaced wells.)  
 (Show footage to the nearest lease or unit boundary line.)

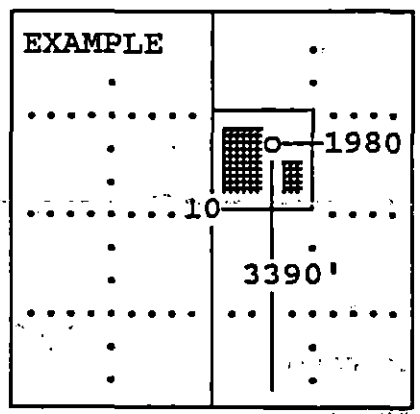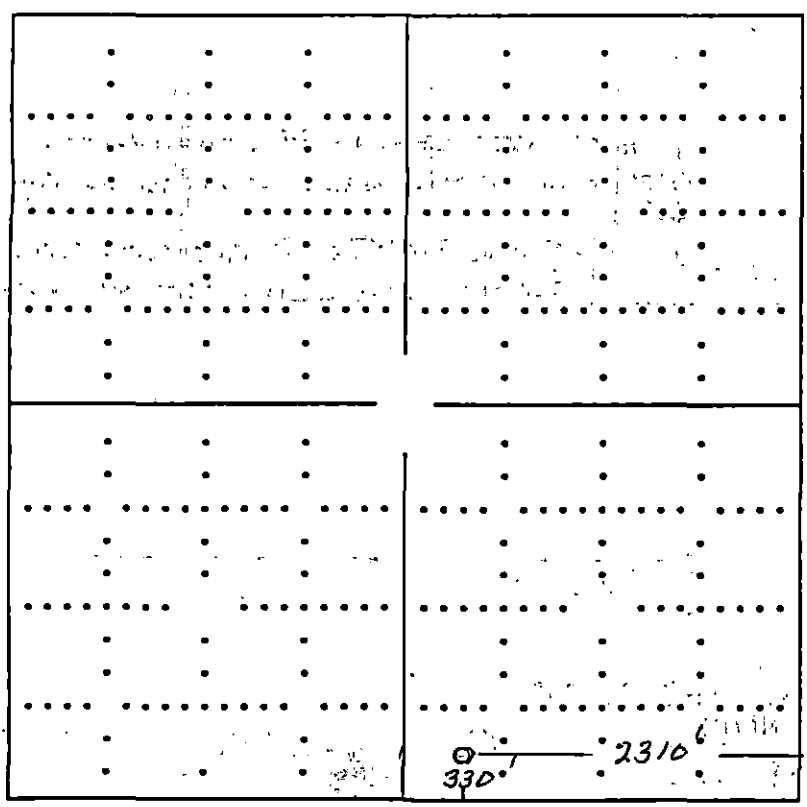

SEWARD CO.

**In plotting the proposed location of the well, you must show:**

- 1) The manner in which you are using the depicted plat by identifying section lines, i.e. 1 section, 1 section with 8 surrounding sections, 4 sections, etc.;
- 2) the distance of the proposed drilling location from the section's south/north and east/west; and
- 3) the distance to the nearest lease or unit boundary line.