

FOR KCC USE:

CORRECTION AS TO LOCATION

first
CORRECTED

FORM C-1 7/91
FORM MUST BE TYPED
FORM MUST BE SIGNED
ALL BLANKS MUST BE FILLED

EFFECTIVE DATE: 6-10-02

DISTRICT # 1
SGA.....Yes.....No.....

State of Kansas
NOTICE OF INTENTION TO DRILL

Must be approved by the K.C.C. five (5) days prior to commencing well

Expected Spud Date.....06.....10.....2002.....
Month day year

Spot approximately 250' northeast of _____ East
C.....NE.....SW.....Sec.....26.....Twp.....32.....S, Rg.18..W _____ West

.....2180.....feet from South North Line of Section

OPERATOR: LICENSE #.....8061.....
Name:.....OIL PRODUCERS, INC. OF KANSAS.....
Address:.....P.O. BOX 8647.....
City/State/Zip:.....WICHITA, KANSAS 67208.....
Contact Person:.....JOHN S. WEIR/DIANA RICHECKY.....
Phone:.....316-681-0231.....

.....3070.....feet from East West Line of Section

IS SECTION _____ REGULAR x _____ IRREGULAR?

(Note: Locate well on the Section Plat on Reverse Side)

County:COMANCHE.....

Lease Name: .DALE A Well #:.....3.....

Field Name:.....

Is this a Prorated / Spaced Field? ...yesno

Target Formation (s):.....Mississippi.....

Nearest Lease or unit boundary:660.....

Ground Surface Elevation : ...est. 2025..... MSL

Water well within one - quarter mile:yes xno

Public water supply well within one mile:yes xno

Depth to bottom of fresh water:150.....

Depth to bottom of usable water:190.....

Surface Pipe by Alternate:x.....1.....2

Length of Surface Pipe Planned to be set: 625.....

Length of Conductor pipe required:0.....

Projected Total Depth :5700.....

Formation at Total Depth:Mississippi.....

Water Source for Drilling Operations:

.....WellFarm Pond.....x.....other —

Permit #:

Will Cores Be Taken?:yes xno —

If yes, proposed zone:

CONTRACTOR: License #:.....4958.....
Name: MALLARD JV, INC.

Well Drilled For:	Well Class:	Type Equipment:
X..OilEnh Recx..Infield
.....GasStoragex..Mud Rotary
.....OWWODisposalPool Extension
.....Seismic:# of HolesAir Rotary
.....Other:OtherCable

If OWWO: old well information as follows:

Operator:

Well Name :

Comp. Date:Total Depth.....

Directional, Deviated or Horizontal wellbore?yes..x...no

If yes, true vertical depth:

Bottom Hole Location.....

AFFIDAVIT *WAS: 1980 FSL ES: 2180 FSL
WAS: 3300 FEL ZS: 3070 FEL

The undersigned hereby affirms that the drilling, completion and eventual plugging of this well will comply with K.S.A. 55-101, et. seq.
It is agreed that the following minimum requirements will be met. :

1. Notify the appropriate district office prior to spudding of well;
2. A copy of the approved notice of intent to drill shall be posted on each drilling rig;
3. The minimum amount of surface pipe as specified below shall be set by circulating cement to the top; in all cases surface pipe shall be set through all unconsolidated materials plus a minimum of 20 feet into the underlying formation;
4. If the well is dry hole, an agreement between the operator and the district office on plug length and placement is necessary prior to plugging;
5. The appropriate district office will be notified before well is either plugged or production casing is cemented in;
6. IF AN ALTERNATE II COMPLETION, PRODUCTION PIPE SHALL BE CEMENTED FROM BELOW ANY USABLE WATER TO SURFACE WITHIN 120 DAYS OF SPUD DATE. IN ALL CASES, NOTIFY DISTRICT OFFICE PRIOR TO ANY CEMENTING.

I hereby certify that the statements made herein are true and to the best of my knowledge and belief

Date...06/10/2002.....Signature of Operator or Agent.....*John S. Weir*.....Title.....President.....

FOR KCC USE:
 API # 15- 033-21319-00-00
 Conductor pipe required NONE feet
 Minimum surface pipe required 200 feet per Alt. ①
 Approved by: RJP 6-5-02 / 7-3-02
 This authorization expires: 12-5-02
 (This authorization void if drilling not started within 6 months of effective date.)
 Spud date: _____ Agent: _____

REMEMBER TO:

- File Drill Pit Application (form CDP - 1) with Intent to Drill;
- File Completion Form ACO -1 within 120 days of spud date;
- File acreage attribution plat according to field proration orders;
- Notify appropriate district office 48 hours prior to workover or re-entry;
- Submit plugging report (CP-4) after plugging is completed;
- Obtain written approval before disposing or injecting salt water.

Mail to: KCC - Conservation Division, 130 S. Market - Room 2078, Wichita, Kansas 67202.

26
32
180

15-033-21319-00-00

IN ALL CASES PLOT THE INTENDED WELL ON THE PLAT BELOW

PLAT OF ACREAGE ATTRIBUTABLE TO A WELL IN A PRORATED OR SPACED FIELD

If the intended well is in a prorated or spaced field, please fully complete this side of the form. If the intended well is in a prorated or spaced field complete the plat below showing that the well will be properly located in relationship to other wells producing from the common source of supply. Please show all the wells within 1 mile of the boundaries of the proposed acreage attribution unit for gas wells and within 1/2 mile of the boundaries of the proposed acreage attribution unit for oil wells.

API NO. 15- _____
OPERATOR OIL PRODUCERS, INC. OF KANSAS
LEASE DALE A
WELL NUMBER #3
FIELD _____

LOCATION OF WELL: COUNTY COMANCHE
2180 feet from South/north line of section
3070 feet from East/west line of section
SECTION 26 TWP 32 S RG 18 W

NUMBER OF ACRES ATTRIBUTABLE TO WELL 160
QTR/QTR/QTR OF ACREAGE _____



IS SECTION X REGULAR or _____ IRREGULAR
IF SECTION IS IRREGULAR, LOCATE WELL FROM NEAREST CORNER BOUNDARY.

Section corner used: SE

PLAT

(Show location of the well and shade attributable acreage for prorated or spaced wells.)
(Show footage to the nearest lease or unit boundary.)

RECEIVED
JUN 25 2000
KCC WICHITA

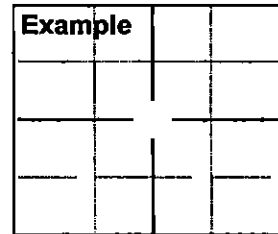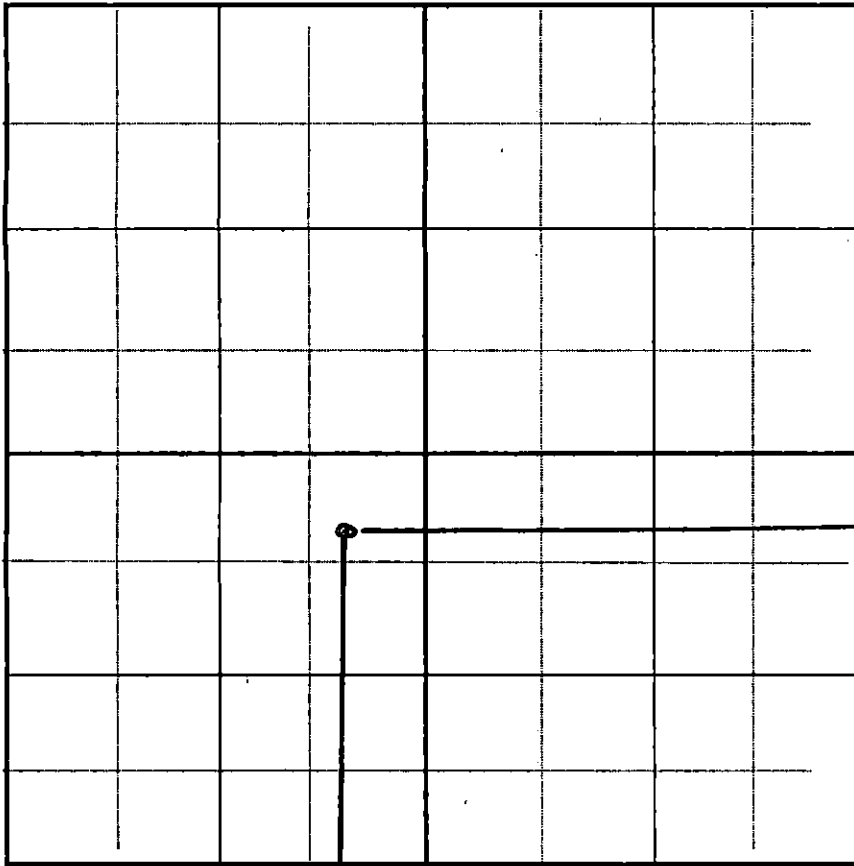

SEWARD CO.

SECTION 26 COMANCHE COUNTY, KANSAS

In plotting the proposed location of the well, you must show:

- 1) The manner in which you are using the depicted plat by identifying section lines, i.e. 1 section, 1 section with 8 surrounding sections, 4 sections, etc.;
- 2) the distance of the proposed drilling location from the section's south/north and east/west; and
- 3) the distance to the nearest lease or unit boundary line.