

CARD MUST BE TYPED

State of Kansas
NOTICE OF INTENTION TO DRILL
(see rules on reverse side)

CARD MUST BE SIGNED

Starting Date: August 8, 1985
month day year

API Number 15- 033-20,682-00-00

OPERATOR: License # 5050
Name Hummon Corporation
Address 400 One Main Place
City/State/Zip Wichita, Kansas 67202
Contact Person Wilber Berg
Phone (316) 263-8521

G. NW SE . . . Sec. 1. Twp 31. S, Rge 19. . .
(location) East West

. . . 1980 Ft North from Southeast Corner of Section
. . . 1980 Ft West from Southeast Corner of Section
(Note: Locate well on Section Plat on reverse side)

CONTRACTOR: License # 5148
Name Big-H Drilling, Inc.
City/State Wichita, Kansas 67202

Nearest lease or unit boundary line 660 feet.
County Comanche
Lease Name Robbins Well# 1

Domestic well within 330 feet: yes no
Municipal well within one mile: yes no

Well Drilled For: Well Class: Type Equipment:
 Oil Swd Infield Mud Rotary
 Gas Inj Pool Ext. Air Rotary
 OWWO Expl Wildcat Cable

Depth to Bottom of fresh water 100 feet
Lowest usable water formation Cheyenne Sd.
Depth to Bottom of usable water 200 feet
Surface pipe by Alternate: 1 2
Surface pipe to be set 250 feet
Conductor pipe if any required None feet
Ground surface elevation 2194 feet MSL
This Authorization Expires 2-2-86
Approved By 8-2-85 *[Signature]*

If OWWO: old well info as follows:
Operator
Well Name
Comp Date Old Total Depth
Projected Total Depth 5200 feet
Projected Formation at TD Mississippi
Expected Producing Formations Lansing, Mississippi

I certify that we will comply with K.S.A. 55-101, et seq., plus eventually plugging hole to K.C.C. specifications.

Date 7-18-85 Signature of Operator or Agent

Kenneth S. White
Title Agent

PCN BK 1076

Must be filed with the K.C.C. five (5) days prior to commencing well
 This card void if drilling starts on this card in six (6) months of date received by K.C.C.

STATE CORPORATION COMMISSION

08-02-1985


AUG 2 1985

Important procedures to follow:

A Regular Section of Land
 1 Mile = 5,280 Ft.

CONSERVATION DIVISION District office before setting surface casing.
 Wichita, Kansas

2. Set surface casing by circulating cement to the top.
3. File completion forms ACO-1 with K.C.C. within 90 days of well completion, following instructions on ACO-1, side 1, and including copies of wireline logs.
4. Notify District office 48 hours prior to old well workover or re-entry.
5. Prior to plugging, prepare a plugging plan, then obtain agreement from the appropriate district office for an approved plugging plan.
6. Submit plugging report (CP-4) to K.C.C. after plugging is completed.
7. Obtain an approved injection docket number before disposing of salt water.
8. Notify K.C.C. within 10 days when injection commences or terminates.
9. If an alternate 2 completion, cement in the production pipe from below any usable water to surface within 120 days of spud date.

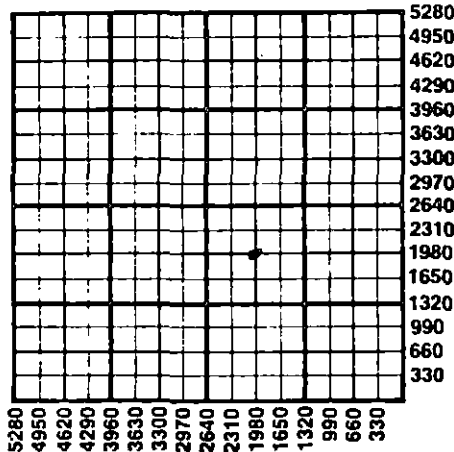

State Corporation Commission of Kansas
 Conservation Division
 200 Colorado Derby Building
 Wichita, Kansas 67202
 (316) 263-3238